IREDELL COUNTY HEALTH DEPARTMENT

Statesville Office (704) 878-5305 Mooresville Office (704) 660-3625 PERMIT # 200561

IMPROVEMENT PERMIT / AUTHORIZATION TO CONSTRUCT / OPERATION PERMIT / EXISTING SYSTEM

PIN # 4821895417

APPLICANT: Dirk Dowell APPLICANT ADDRESS: 368 Sprinkle Rd.

SITE ADDRESS: 368 Sprinkle Rd. PHONE: 704-592-5162 ALT. PHONE: 704-903-8728


SITE DIRECTIONS: Hwy 115 N TR Sprinkle Rd. Property on Left.

SUBDIVISION: N/A SECTION: N/A LOT # N/A LOT AREA: 31.79 acres DESIGN FLOW: 360 gpd L.T.A.R.: 0.3

Septic Tank	1000 gal	STB	760	Date	9-2-13	☐ New System	☑ Repair	☐ Expansion	System Type: I II III IV V VI	☑ Residence	No. Bedrooms 3	Water Supply
Pump Tank	N/A gal	PT	N/A	Date	N/A	System Description:				☐ Business	No. Persons 6	☑ Private
Pump Make	N/A	Model	Poly Tek	Serial #	PL-68	Repair System Description:	25% Reduction			☐ Other	No. Employees	☐ Public
# Nitrification Fields	1	# Lines	6	Linear Ft:	300	Maintenance Agreement Required:	☐ YES	☑ NO		☐ Slab	☑ Crawl Space	☐ Community
Trench Width	36"	Max. Trench Bottom Depth	36"	Gravel Depth	N/A		☑ GRAVITY	☐ PRESSURE		☐ Basement w/plumbing	☐ Basement w/o plumbing	

Comments / Conditions: Install a 25% Reduction system on contours with serial distribution. Supply line shall be constructed of ductile iron or equivalent under driveway unless 30" cover can be maintained. Replace septic tank if needed.

INITIAL SITE SKETCH

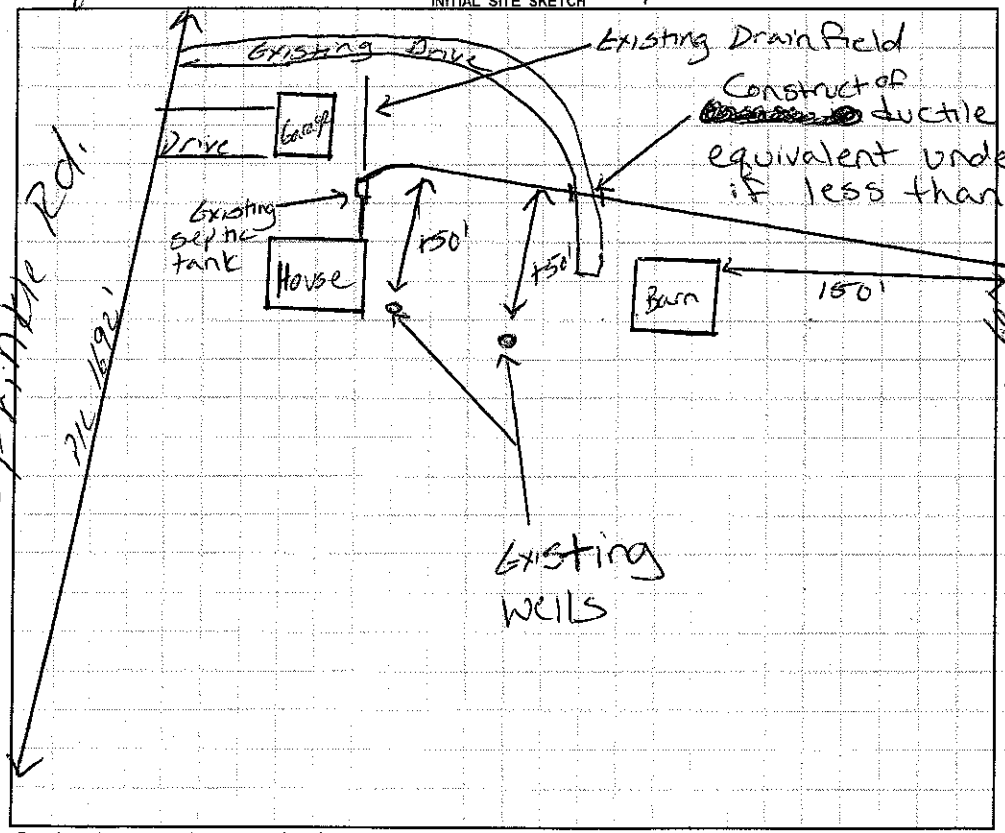

AS BUILT SKETCH

Quick installed as drawn

Permit can be suspended or revoked if any false information is supplied toward securing the permit / any unauthorized changes are made to the site / any unauthorized changes are made in the installation of the system. **CONTACT A LOCATOR SERVICE PRIOR TO ANY EXCAVATION**

☐ **IMPROVEMENT PERMIT** *with plat* valid without expiration. ☑ **IMPROVEMENT PERMIT** *with site plan* valid for 60 mos. ☑ **AUTHORIZATION TO CONSTRUCT** valid for period equal to IMPROVEMENT PERMIT--not to exceed 60 mo.

Owner / Applicant Signature: Dirk Dowell Date:

Installed by: A-1 Backhoe

IMPROVEMENT PERMIT by: Justin Henderson Date: 12-19-13

OPERATION PERMIT by: John Adcock Date: 03/14/14

AUTHORIZATION TO CONSTRUCT by: Justin Henderson Date: 12-19-13

Existing System Inspected by: Date:

Health Dept. Copy - WHITE Applicant (Final Approval) - YELLOW Applicant (Conditional Approval) - PINK