IREDELL COUNTY HEALTH DEPARTMENT

Statesville Office (704) 878-5305 Mooresville Office (704) 660-3625 PERMIT # 21467S BP

IMPROVEMENT PERMIT / AUTHORIZATION TO CONSTRUCT / OPERATION PERMIT / EXISTING SYSTEM

PIN # 4821-94-4448.000

APPLICANT: Ashcraft Custom Homes APPLICANT ADDRESS: 428 Augusta Dr. Statesville NC

SITE ADDRESS: 1464 Friendship Rd. Statesville NC PHONE: 704-634-7082 ALT. PHONE: 704-450-1907

SITE DIRECTIONS: 115 N, TR Friendship Rd., Site on L

SUBDIVISION: — SECTION: — LOT # — LOT AREA: 5 Acre DESIGN FLOW: Ex. 360 GPD L.T.A.R.: Existing

Septic Tank Existing (gal) STB Date
Pump Tank (gal) PT Date
Pump Make Model Serial #
Nitrification Fields Ex. # Lines Ex. Linear Ft: Ex.
Trench Width Ex. Max. Trench Bottom Depth Ex. Gravel Depth Ex.


☐ New System ☐ Repair ☐ Expansion System Type: I (II) III IV V VI
System Description: Existing Conventional
Repair System Description: Conventional
Maintenance Agreement Required: ☐ YES ☒ NO
☒ GRAVITY ☐ PRESSURE

☒ Residence No. Bedrooms Ex. 3
☐ Business No. Persons Ex. 6
☐ Other No. Employees
☐ Slab ☐ Crawl Space
☒ Basement w/plumbing ☐ Basement w/o plumbing


Water Supply: ☒ Private ☐ Public ☐ Community

Comments / Conditions: System Deficiencies To Be Functioning @ Time of Inspection.
Addition Should Not Impact Septic System.

INITIAL SITE SKETCH

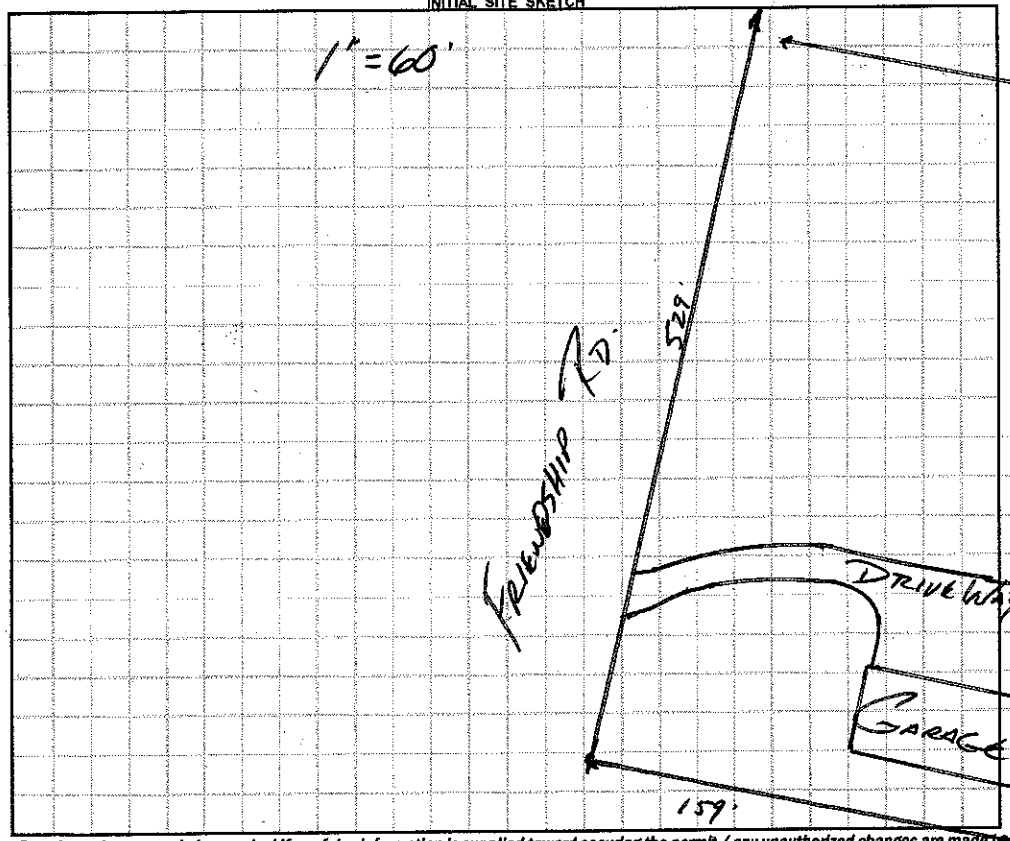

AS BUILT SKETCH

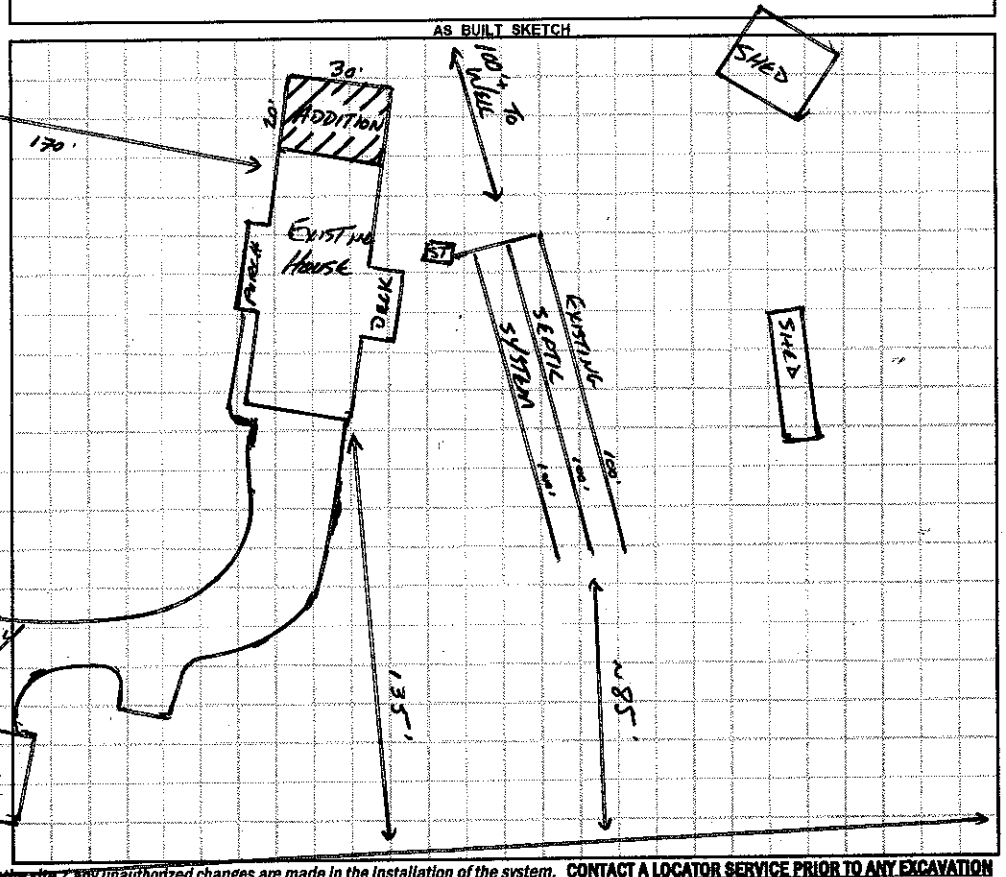

Permit can be suspended or revoked if any false information is supplied toward securing the permit / any unauthorized changes are made to the site / any unauthorized changes are made in the installation of the system. **CONTACT A LOCATOR SERVICE PRIOR TO ANY EXCAVATION**

☐ **IMPROVEMENT PERMIT** *with plat valid without expiration.* ☐ **IMPROVEMENT PERMIT** *with site plan valid for 60 mos.* ☐ **AUTHORIZATION TO CONSTRUCT** *valid for period equal to IMPROVEMENT PERMIT--not to exceed 60 mo.*

Owner / Applicant Signature: Danny K. Ashcraft Date: 12-22-15 Installed by:

IMPROVEMENT PERMIT by: Date: OPERATION PERMIT by: Date:

AUTHORIZATION TO CONSTRUCT by: Date: Existing System Inspected by: Date: 12/21/15

Health Dept. Copy - WHITE Applicant (Final Approval) - YELLOW Applicant (Conditional Approval) - PINK