IREDELL COUNTY HEALTH DEPARTMENT

STATESVILLE 704-878-5305 (at) MOORESVILLE 704-664-5281

THIS PERMIT REPLACES PERMIT ISSUED 11-6-07

IMPROVEMENT PERMIT / AUTHORIZATION TO CONSTRUCT / OPERATION PERMIT / EXISTING SYSTEM INSPECTION

PERMIT # 146028 PIN # 4821 95 2398 DATE 8-31-09

OWNER or APPLICANT Drude Corbet PHONE: Business Home: 704 598 9205

OWNER or APPLICANT ADDRESS P.O. Box 30083 Charlotte NC 28230

LOCATION / DIRECTIONS 115 N, (R) on Friendship, 1.0 M/P on (L)

SUBDIVISION n/a BLOCK / SECTION n/a LOT # LOT AREA 17.62 Ac DESIGN FLOW 480 L.T.A.R. .3

Septic Tank 1000 Gallons: STB 1212 Date 5-16-07

Pump Tank Gallons: P T Date

Pump Make Model Serial #

Nitrification Field No Fields 1 No Lines 3 Linear Feet 400 total

Trench Width 36" Max. Trench Bottom Depth 36" Gravel Depth n/a

☒ New System ☐ Repair ☐ Expansion System Type I II III IV V VI

System Description: 25% Reduction Gravity

Repair System Description: 25% Reduction Gravity

Maintenance Agreement Required ☐ YES ☒ NO

☒ GRAVITY ☐ PRESSURE


☒ Residence No. Bedrooms 4 ☐ Business No. Persons ☐ Other No. Employees ☐ Slab ☐ Crawl Space ☐ Basement w/plumbing ☐ Basement w/o plumbing

Water Supply: ☒ Private ☐ Public ☐ Community


Comments / Conditions

Comments / Conditions 5T has Risers on inlet & outlet.

INITIAL SITE SKETCH

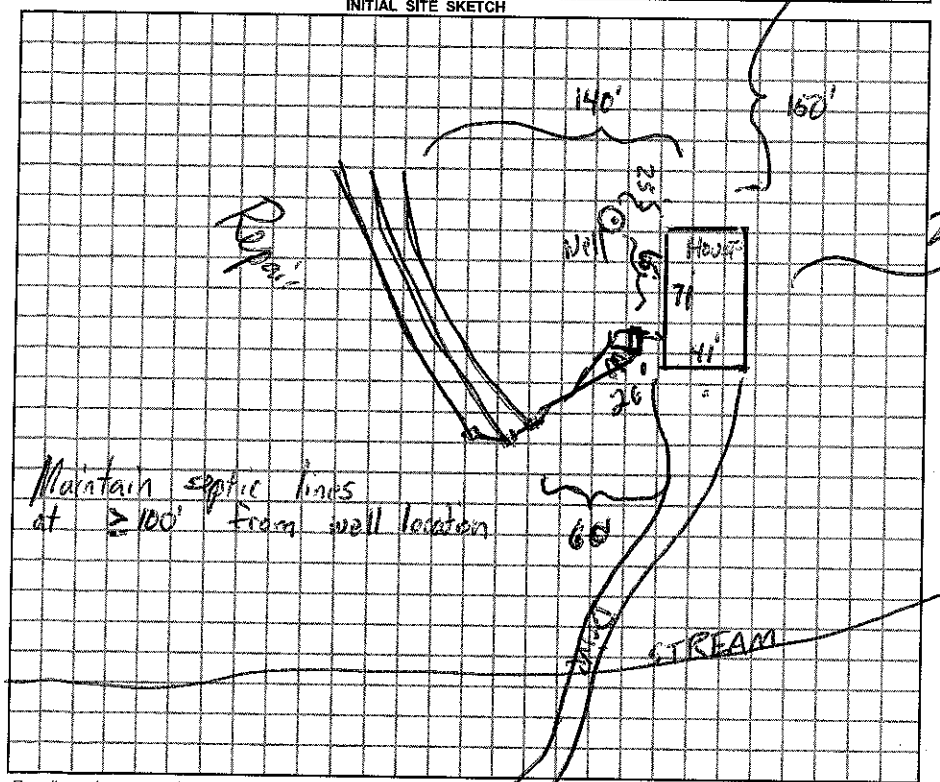

AS BUILT SKETCH

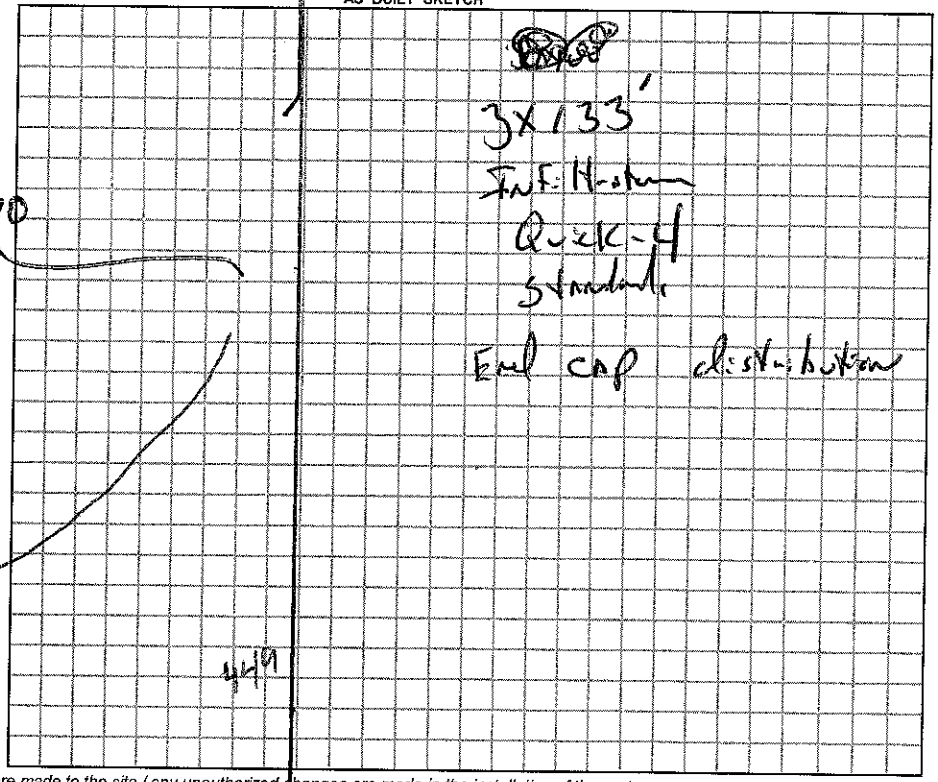

Permit can be suspended or revoked if any false information is supplied toward securing the permit / any unauthorized changes are made to the site / any unauthorized changes are made in the installation of the system.

☐ IMPROVEMENT PERMIT w / plat valid without expiration. ☒ IMPROVEMENT PERMIT w / site plan valid for 60 mo. ☒ AUTHORIZATION TO CONSTRUCT valid for period equal to IMPROVEMENT PERMIT-not to exceed 60 mo.

Owner / Applicant Signature: Drude S Corbet Date 9-1-09

Improvement Permit by: Date 8-31-09

Authorization to Construct by: Date 8-31-09

YOU SHOULD CONTACT A LOCATOR SERVICE PRIOR TO ANY EXCAVATION.

Installed by: Gunter Grubbs

Operation Permit by: R.S. Date: 11 September 09

Existing System Inspected by: Date:

WHITE COPY Environmental Health YELLOW COPY (Final) Owner / Applicant PINK COPY (Initial) Owner / Applicant