See attached Permit #162131 for garage addition.

IREDELL COUNTY HEALTH DEPARTMENT

STATESVILLE 704-878-5305 (a) MOORESVILLE 704-664-5281

IMPROVEMENT PERMIT / AUTHORIZATION TO CONSTRUCT / OPERATION PERMIT / EXISTING SYSTEM INSPECTION

PERMIT # 153411 PIN # 4821958127 7531 DATE 2-10-09

OWNER or APPLICANT Terry Garrison PHONE: Business Home: 704 902 5253

OWNER or APPLICANT ADDRESS 1460 Friendship Rd.

LOCATION / DIRECTIONS 77 N to exit 54, turn (R), then (L) on Jennings, go 5.1 miles to (L) on Friendship - (R) at 1460

SUBDIVISION n/a BLOCK / SECTION n/a LOT # n/a LOT AREA DESIGN FLOW 360 L.T.A.R. .3

Septic Tank 1000 Gallons: STB Date

Pump Tank Gallons: P T Date

Pump Make Model Serial #

Nitrification Field No Fields 1 No Lines 4 Linear Feet 400

Trench Width 36" Max. Trench Bottom Depth 36" Gravel Depth 12"

[X] New System [ ] Repair [ ] Expansion System Type I II III IV V VI

System Description: Conventional Gravity

Repair System Description: Conventional Gravity

Maintenance Agreement Required [ ] YES [X] NO

[X] GRAVITY [ ] PRESSURE

[X] Residence No. Bedrooms 3

[ ] Business No. Persons

[ ] Other No. Employees

[X] Slab [ ] Crawl Space


[ ] Basement w/plumbing [ ] Basement w/o plumbing

Water Supply: [X] Private [ ] Public [ ] Community


Comments / Conditions

Comments / Conditions

INITIAL SITE SKETCH

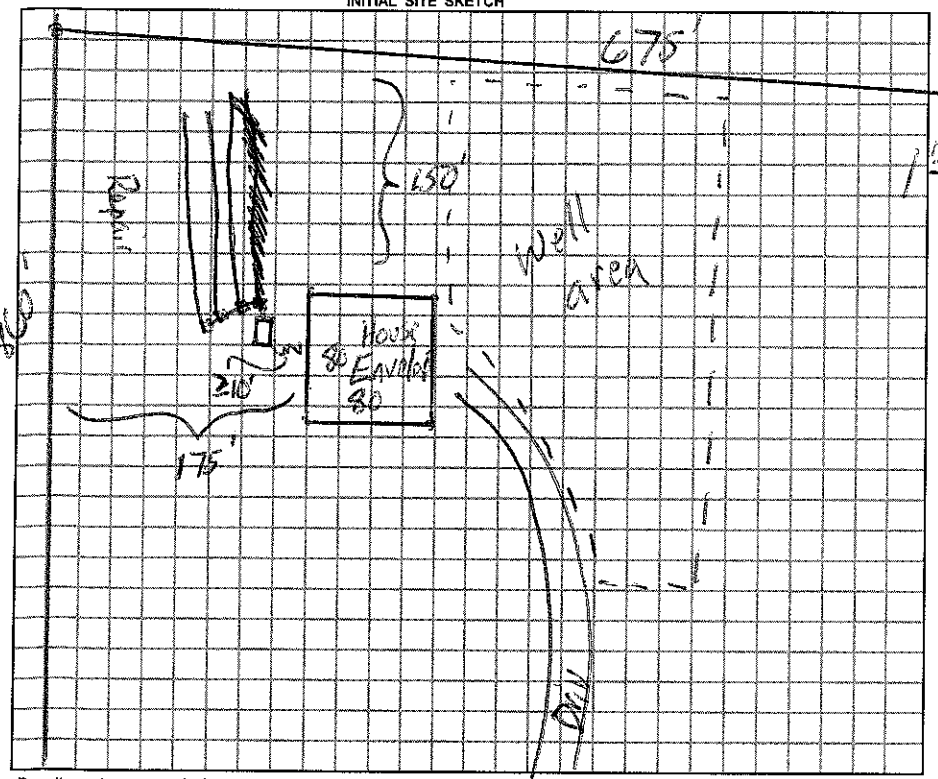

AS BUILT SKETCH

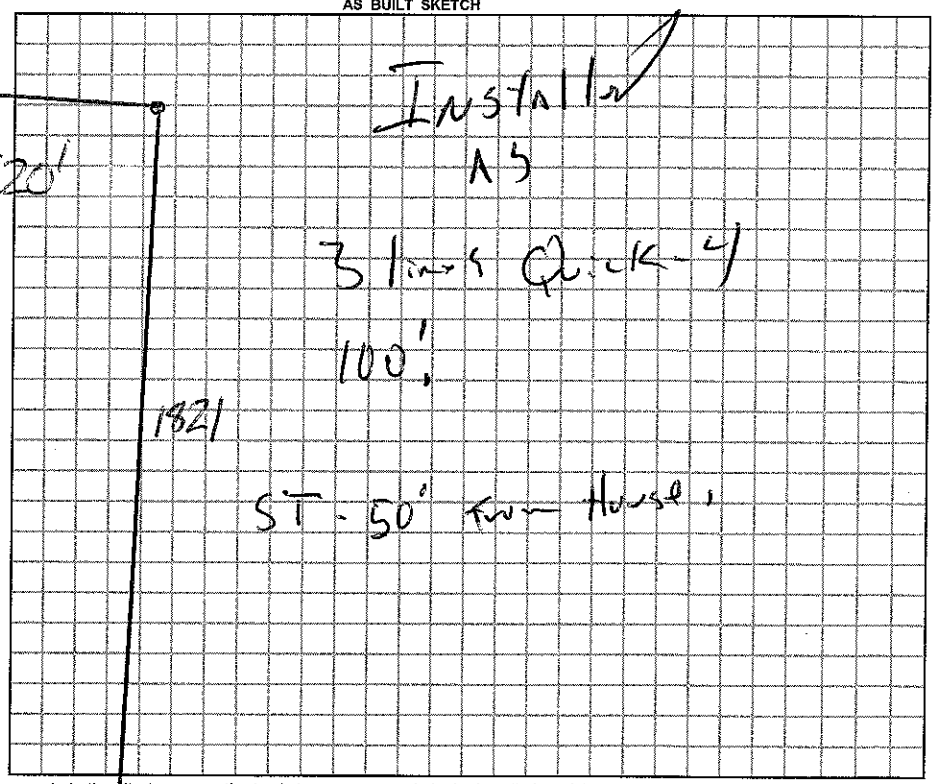

Permit can be suspended or revoked if any false information is supplied toward securing the permit / any unauthorized changes are made to the site / any unauthorized changes are made in the installation of the system.

[ ] *IMPROVEMENT PERMIT w / plat valid without expiration.* [X] *IMPROVEMENT PERMIT w / site plan valid for 60 mos.* [X] *AUTHORIZATION TO CONSTRUCT valid for period equal to IMPROVEMENT PERMIT-not to exceed 60 mo.*

Owner / Applicant Signature: Jane Garrison Date 2-10-09

Improvement Permit by: James Date 2-10-09

Authorization to Construct by: James Date 2-10-09

Installed by: Tim Abel

Operation Permit by: RS Date: 26 Aug 09

Existing System Inspected by: Date:

YOU SHOULD CONTACT A LOCATOR SERVICE PRIOR TO ANY EXCAVATION.

WHITE COPY Environmental Health YELLOW COPY (Final) Owner / Applicant PINK COPY (Initial) Owner / Applicant