IREDELL COUNTY HEALTH DEPARTMENT

STATESVILLE 704-878-5305 (a) (2) MOORESVILLE 704-664-5281 A

IMPROVEMENT PERMIT / AUTHORIZATION TO CONSTRUCT / OPERATION PERMIT / EXISTING SYSTEM INSPECTION

PERMIT # 159389 PIN # 4822099532 9266 DATE 3-22-10

OWNER or APPLICANT JOEL Hepler PHONE: Business Home: 7049244025

OWNER or APPLICANT ADDRESS 125 Race Path Rd Union Grove NC 28689

LOCATION / DIRECTIONS 115 (L) Race Path (L) 1st Drive on Left Follow Drive At Y go right to top of hill

SUBDIVISION BLOCK / SECTION LOT # LOT AREA 5.146 DESIGN FLOW 360 L.T.A.R. .3

Septic Tank 1000 Gallons: STB Date

Pump Tank Gallons: P T Date

Pump Make Model Serial #

Nitrification Field No Fields 1 No Lines 3 Linear Feet 400'

Trench Width 36" Max. Trench Bottom Depth 36" Gravel Depth 12"

☒ New System ☐ Repair ☐ Expansion System Type I (II) III IV V VI

System Description: Gravity Conventional

Repair System Description: Gravity 25% REDUCTION

Maintenance Agreement Required ☐ YES ☒ NO

☒ GRAVITY ☐ PRESSURE

☒ Residence No. Bedrooms 3

☐ Business No. Persons 4

☐ Other No. Employees

☐ Slab ☒ Crawl Space

☐ Basement w/plumbing ☐ Basement w/o plumbing

Water Supply: ☒ Private ☐ Public ☐ Community

Comments / Conditions (1) An Diverted System Can be Used (2) Install Lines on Contours & maintain Setbacks (3) System IS FLAGGED OUT.

Comments / Conditions

INITIAL SITE SKETCH

SEE ATTACHED SYSTEM DESIGN BY LORNE COOK, R.S.

AS BUILT SKETCH

Permit can be suspended or revoked if any false information is supplied toward securing the permit / any unauthorized changes are made to the site / any unauthorized changes are made in the installation of the system.

☐ *IMPROVEMENT PERMIT w / plat valid without expiration.* ☐ *IMPROVEMENT PERMIT w / site plan valid for 60 mos.* ☒ *AUTHORIZATION TO CONSTRUCT valid for period equal to IMPROVEMENT PERMIT-not to exceed 60 mo.*

Owner / Applicant Signature: Date 3-23-10

Improvement Permit by: Date 3-22-10

Authorization to Construct by: Date 3-22-10

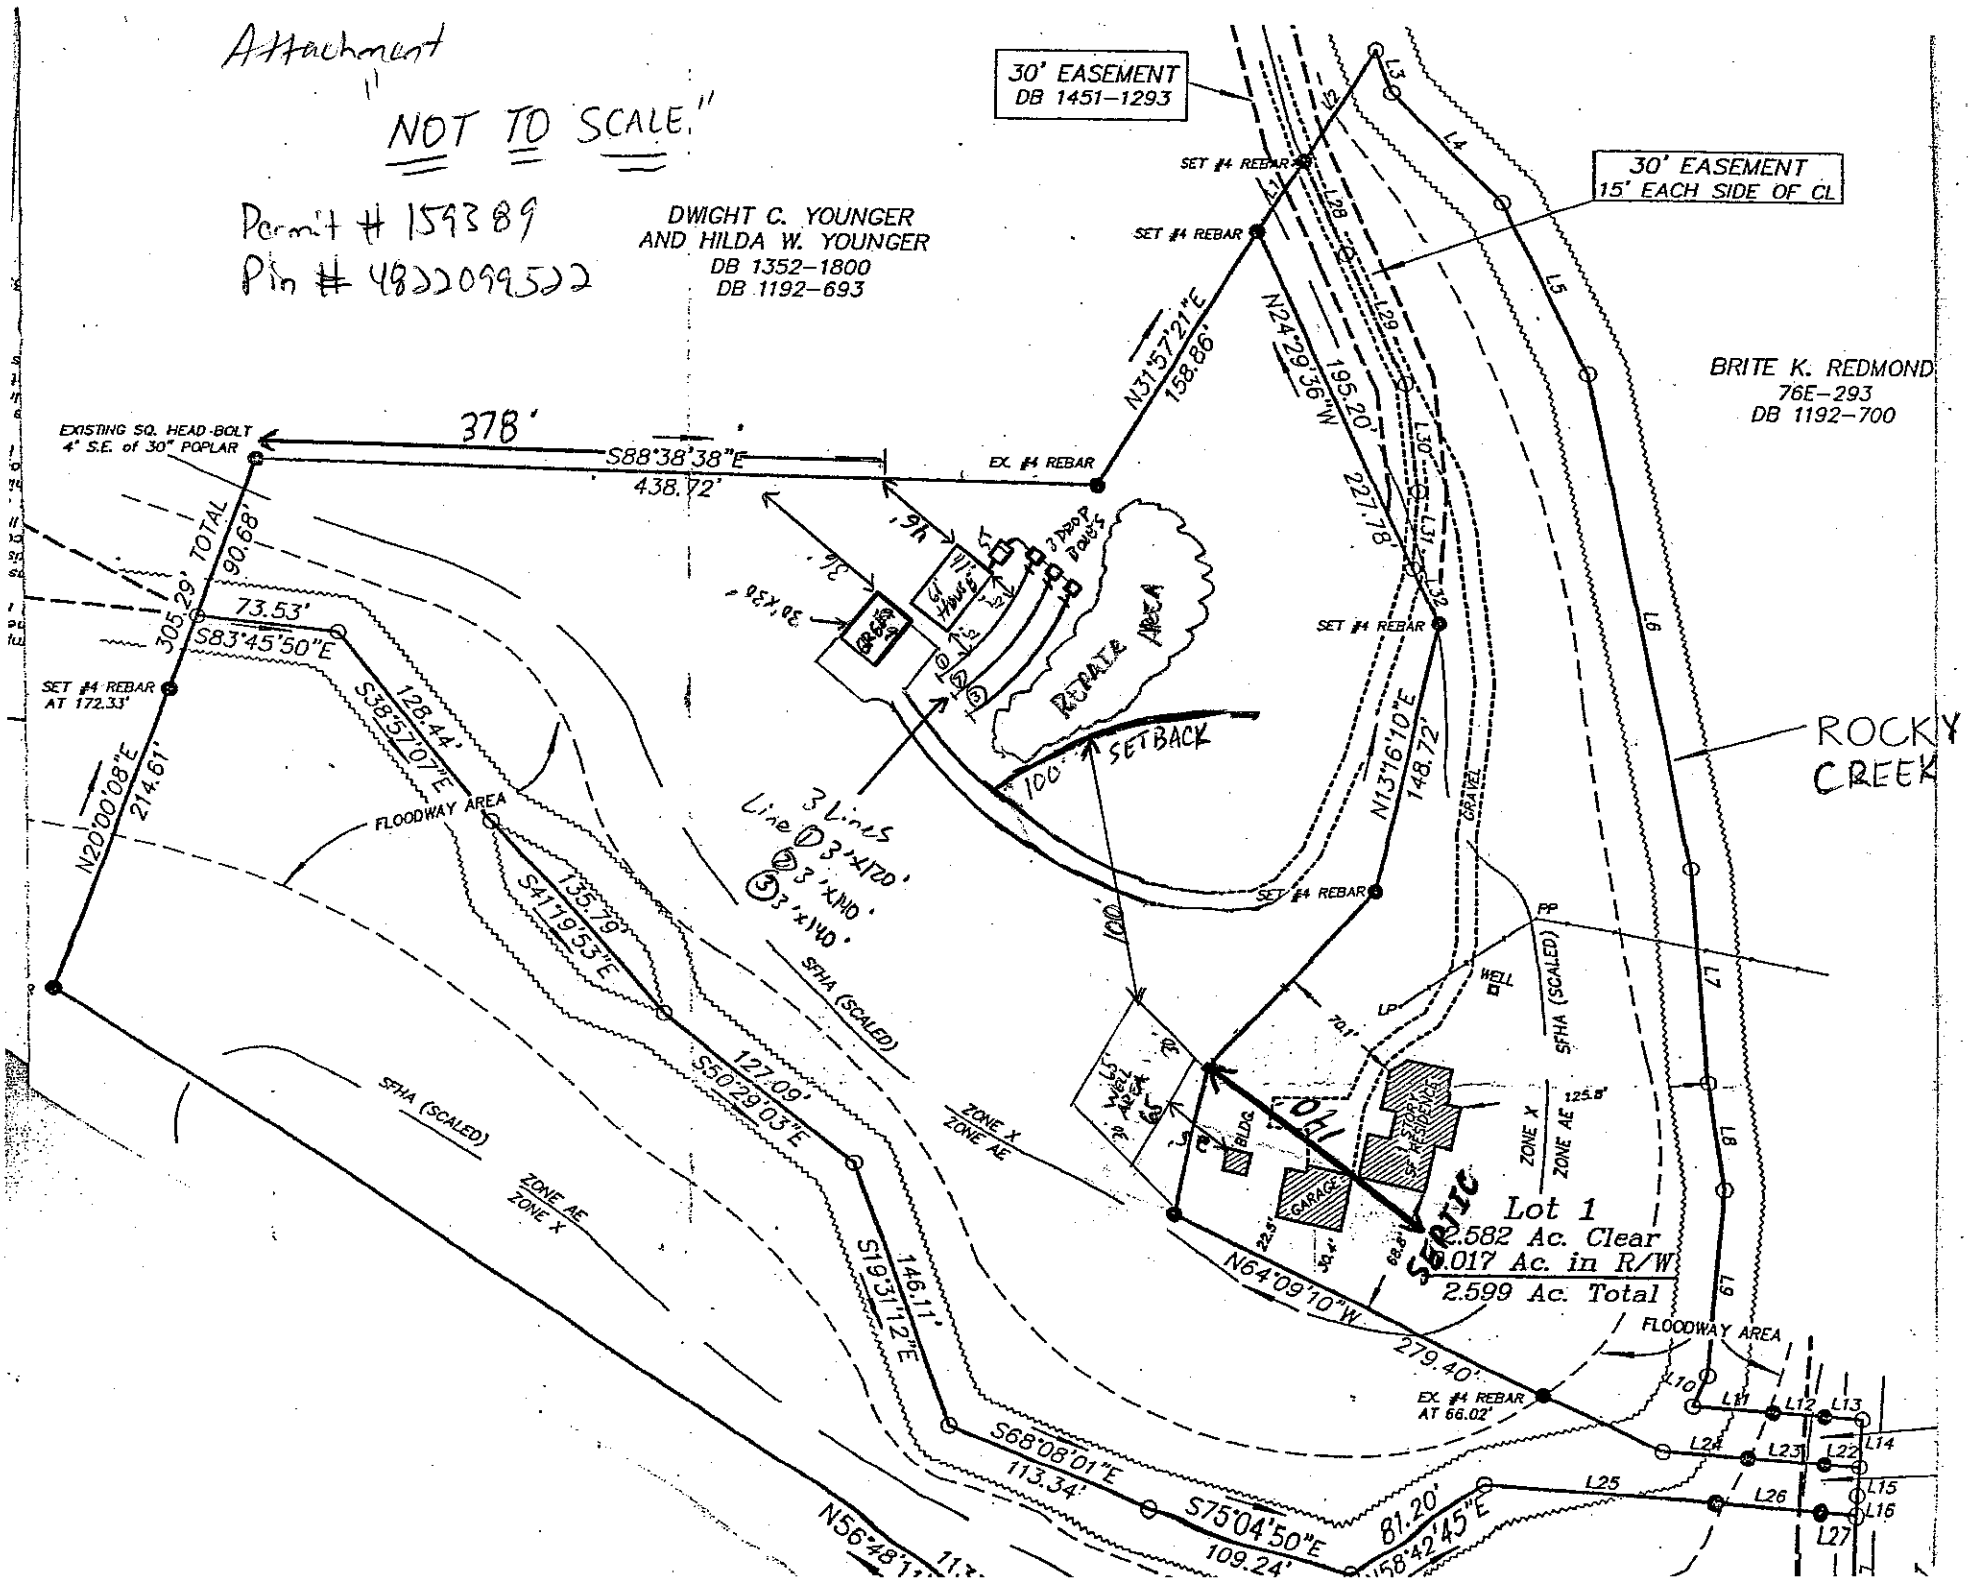
Installed by: K-1 Backhoe

Operation Permit by: Date: 6-14-10

Existing System Inspected by: Date:

YOU SHOULD CONTACT A LOCATOR SERVICE PRIOR TO ANY EXCAVATION.

WHITE COPY Environmental Health YELLOW COPY (Final) Owner / Applicant PINK COPY (Initial) Owner / Applicant


Attachment
"NOT TO SCALE"
Permit # 159389
Pin # 4822099522
DWIGHT C. YOUNGER
AND HILDA W. YOUNGER
DB 1352-1800
DB 1192-693
30' EASEMENT
DB 1451-1293
30' EASEMENT
15' EACH SIDE OF CL
BRITE K. REDMOND
76E-293
DB 1192-700
ROCKY
CREEK
SET #4 REBAR
EX. #4 REBAR
EXISTING SQ. HEAD-BOLT
4' S.E. of 30" POPLAR
SET #4 REBAR
AT 172.33'
S88°38'38"E
438.72'
378'
305.29' TOTAL
90.68'
73.53'
S83°45'50"E
N20°00'08"E
214.61'
S38°57'07"E
128.44'
FLOODWAY AREA
S41°19'53"E
135.79'
127.09'
S50°29'03"E
146.11'
S19°31'12"E
S68°08'01"E
113.34'
S75°04'50"E
109.24'
N56°48'11"
N31°57'21"E
158.86'
N24°29'36"W
195.20'
227.78'
N13°16'10"E
148.72'
N64°09'10"W
279.40'
81.20'
S58°42'45"E
100' SETBACK
3 Lines
Line 1 3'x120'
Line 2 3'x140'
Line 3 3'x140'
REPAIR AREA
GRAVEL
SFHA (SCALED)
ZONE X
ZONE AE
WELL
LP
PP
SEPTIC
GARAGE
BLDG.
Lot 1
2.582 Ac. Clear
0.017 Ac. in R/W
2.599 Ac. Total
L1
L2
L3
L4
L5
L6
L7
L8
L9
L10
L11
L12
L13
L14
L15
L16
L17
L18
L19
L20
L21
L22
L23
L24
L25
L26
L27
L28
L29
L30
L31
L32