54295

IREDELL COUNTY HEALTH DEPARTMENT

STATESVILLE 704-878-5305 MOORESVILLE 704-664-5281

IMPROVEMENT PERMIT / CERTIFICATE OF COMPLETION / OPERATION PERMIT / EXISTING SYSTEM INSPECTION

PROPERTY DESCRIPTION NO. 20032 DATE 1/10/95 TAX MAP NO. 15E-A-47 Watershed: ☐ Yes ☒ No

OWNER OR CONTRACTOR JEFFREY HOLDER PHONE: Business Home 528-9446

ADDRESS 137 CURTIS DRIVE, MOORESVILLE, NC 28115

LOCATION NC 115 NORTH, PAST CARDINWOODY ROAD, 1ST DRIVE ON LEFT PAST JORDAN'S TEXACO


SUBDIVISION BLOCK / SECTION LOT LOT AREA 4.4 ACRES SITE CLASS. PS DESIGN FLOW 240 L.T.A.R. EXISTING

Septic Tank: EXISTING Gallons; STB Date	☐ New System ☐ Repair System Type: I, II, III, IV, V, VI	☐ House/Mod. Home No. Bedrooms 2	Water Supply:
Pump Tank: Gallons; PT Date	System Description: CONVENTIONAL GRAVITY	☒ Mobile Home No. Bathrooms 2	☒ Individual
Pump Make: Model Serial No.	Repair System Description: CONV. GRAVITY	☐ Business No. Employees	☐ Community
Nitrification Field: No Fields Square Feet Linear Feet EXISTING	Maintenance Agreement Required: ☐ Yes ☒ No	☐ Other	☐ Public
No Lines Trench Width Max Trench Bottom Depth Gravel Depth	☐ Slab ☒ Crawl Space ☐ Basement w/plumbing ☐ Basement wo/plumbing		WELL

Comments:

Comments:

AS BUILT SKETCH

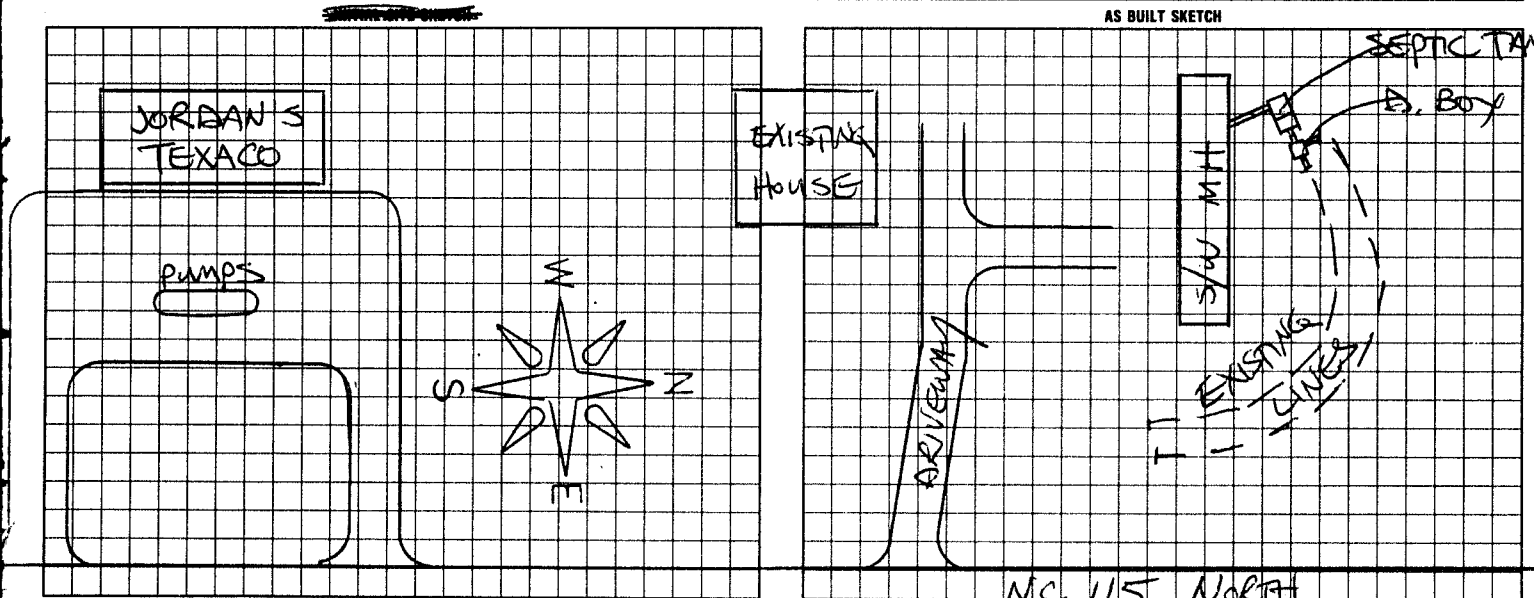

I understand that this permit can be suspended or revoked if any false information is supplied toward securing the permit,any unauthorized changes are made to the site/any unauthorized changes are made in the installation of the system. Improvement Permit is valid for 60 months from date of issuance.

Signed:

Improvement Permit by: STEVE HEDRICK date 1/10/95

Existing System Inspection by: STEVE HEDRICK date 1/10/95

Installed by:

Certificate of Completion by: date

Operation Permit by: date

HEALTH DEPT. COPY: WHITE INSPECTION COPY (FINAL): GREEN OWNER COPY (FINAL): YELLOW INSPECTION COPY (INITIAL): PINK OWNER COPY (INITIAL): GOLD