IREDELL COUNTY HEALTH DEPARTMENT

STATESVILLE 704-878-5305 MOORESVILLE 704-664-5281

IMPROVEMENT PERMIT / AUTHORIZATION TO CONSTRUCT / OPERATION PERMIT / EXISTING SYSTEM INSPECTION

PERMIT# 088030 PIN# 4822 38 6429 (PT) DATE 3-10-00

OWNER OR CONTRACTOR CAROLYN THOMPSON PHONE: Business Home 876-4161

ADDRESS 3579 WILKESBORO Hwy, STATESVILLE, NC 28625

LOCATION NC 115 North, TR RUPARD ROAD 0.4 MILE ON RIGHT

SUBDIVISION BLOCK / SECTION LOT LOT AREA 8½ ACRES SITE CLASS PS DESIGN FLOW 360 L.T.A.R. 0.40 GPA/FR

Septic Tank: 1000 Gallons; STR 1012 Date 6-24-00
Pump Tank: Gallons; PT Date
Pump Make: Model Serial No.
Nitrification Field: No Fields 1 Square Feet 900 Linear Feet 300
No Lines THREE Trench Width 36" Max Trench Bottom Depth 20" Gravel Depth 12"

☑ New System ☐ Repair System Type: I (II) III. IV. V. VI
System Description: CONVENTIONAL, GRAVITY
Repair System Description: CONVENTIONAL, GRAVITY
Maintenance Agreement Required: ☐ Yes ☑ No

☑ House/Mod. Home No. Bedrooms 3
☐ Mobile Home No. Bathrooms 2
☐ Business No. Employees
☐ Other


☐ Slab ☑ Crawl Space ☐ Basement w/plumbing ☐ Basement wo/plumbing

Water Supply: ☑ Individual ☐ Public ☐ Community WELL


Comments:/Conditions: ① INSTALL LINES ON CONTOUR, NO DEEPER THAN 20"
② KEEP SYSTEM MINIMUM 100' FROM WELL

Comments:/Conditions:

INITIAL SITE SKETCH

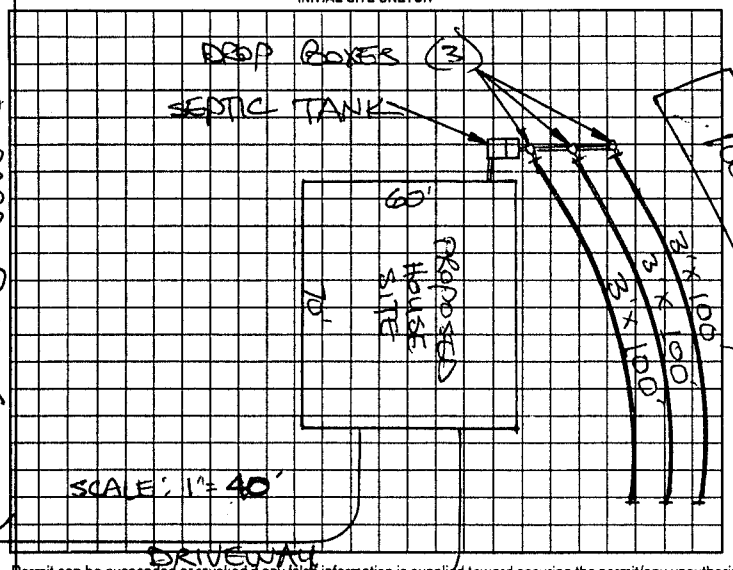

AS BUILT SKETCH

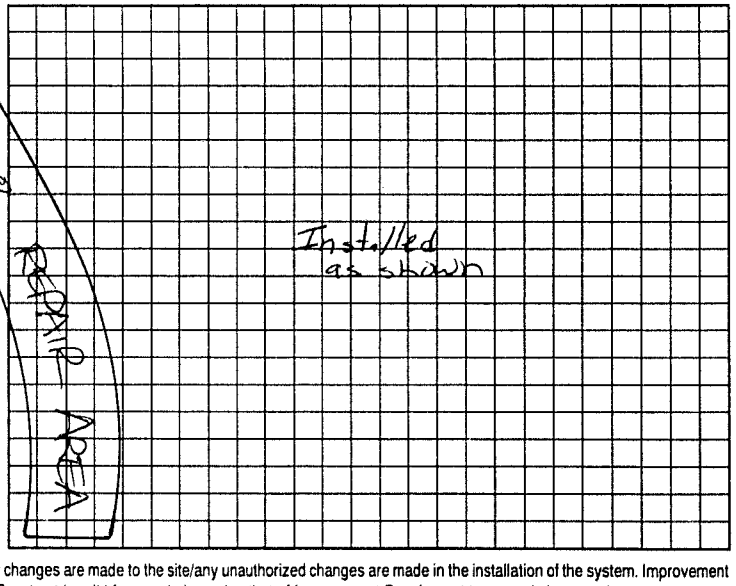

Permit can be suspended or revoked if any false information is supplied toward securing the permit/any unauthorized changes are made to the site/any unauthorized changes are made in the installation of the system. Improvement Permit with plat valid without expiration. Improvement Permit with site plan valid for sixty months. Authorization to Construct is valid for a period equal to that of Improvement Permit – not to exceed sixty months.

Signed: Carolyn Thompson date 3-10-00 Installed by: Tommy Fite

Improvement Permit by: STEVE HEDRICK date 3-10-00 Operation Permit by: Mark Cox RS date 11-14-00

Authorization to Construct by: STEVE HEDRICK date 3-10-00 Existing System Inspection by: date

HEALTH DEPT. COPY: WHITE OWNER COPY (FINAL): YELLOW OWNER COPY (INITIAL): PINK