IREDELL COUNTY HEALTH DEPARTMENT

Statesville Office (704) 878-5305 Mooresville Office (704) 660-3625 PERMIT # 220033

IMPROVEMENT PERMIT / AUTHORIZATION TO CONSTRUCT / OPERATION PERMIT / EXISTING SYSTEM

PIN # 4822 38 6653 #308

APPLICANT: BILLY J BURGESS JR. APPLICANT ADDRESS: 306 RUPARD RD. STATESVILLE, N.C. 28625

SITE ADDRESS: 308 RUPARD RD. PHONE: 704-495-3320 ALT. PHONE:

SITE DIRECTIONS: 306 RUPARD RD. STATESVILLE, NC. 28625

SUBDIVISION: N/A SECTION: LOT # LOT AREA: 23.69 AC DESIGN FLOW: 240 L.T.A.R.: .25

Septic Tank 1000 (gal) STB 1012 Date 2/14/16
Pump Tank (gal) PT Date
Pump Make Model Serial #
Nitrification Fields 1 # Lines 4 @ 60'x3' Linear Ft: 240
Trench Width 3' Max. Trench Bottom Depth 33" Gravel Depth N/A


☒ New System ☐ Repair ☐ Expansion System Type: I II ◉ IV V VI
System Description: GRAVITY - TYPE III MATERIAL
Repair System Description: SAME 25% Reduction
Maintenance Agreement Required: ☐ YES ☒ NO
☒ GRAVITY ☐ PRESSURE

☑ Residence No. Bedrooms 1 (2)
☐ Business No. Persons 4
☐ Other No. Employees
☐ Slab ☒ Crawl Space
☐ Basement w/plumbing ☐ Basement w/o plumbing

Water Supply: ☑ Private ☐ Public ☐ Community

Comments / Conditions: SOIL MATERIAL HAS FLOATING ROCK AT AND BELOW 30", FOUND NO CONSOLIDATED STONE

INITIAL SITE SKETCH

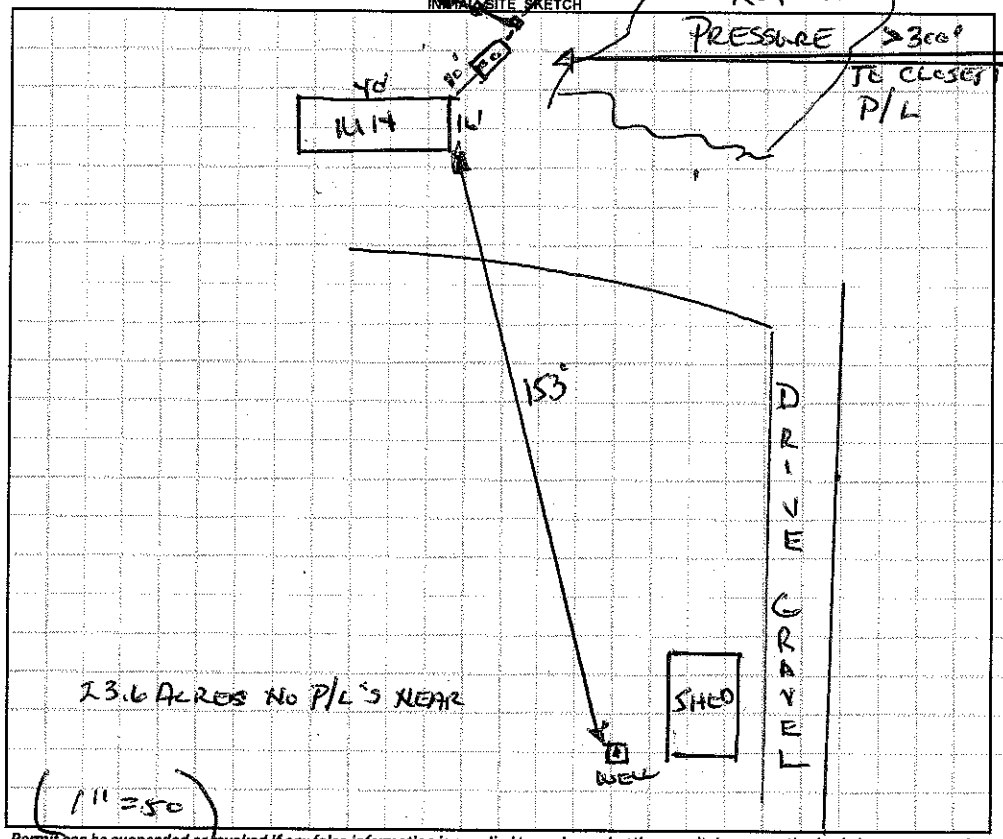

AS BUILT SKETCH

Permit can be suspended or revoked if any false information is supplied toward securing the permit / any unauthorized changes are made to thee site / any unauthorized changes are made in the installation of the system. CONTACT A LOCATOR SERVICE PRIOR TO ANY EXCAVATION

☐ IMPROVEMENT PERMIT *with plat* valid without expiration. ☒ IMPROVEMENT PERMIT *with site plan* valid for 60D mos. ☒ AUTHORIZATION TO CONSTRUCT valid for period equal to IMPROVEMENT PERMIT--not to exceed 60 mo.

Owner / Applicant Signature: Billy J Burgess Jr. Date: 8/22/16 Installed by: Shawn Jarrett Sandy

IMPROVEMENT PERMIT by: W Sparks Date: 8/17/16 OPERATION PERMIT by: W Sparks Date: 11/30/16

AUTHORIZATION TO CONSTRUCT by: W Sparks Date: 8/17/16 Existing System Inspected by: Date:

Health Dept. Copy - WHITE Applicant (Final Approval) - YELLOW Applicant (Conditional Approval) - PINK