IREDELL COUNTY HEALTH DEPARTMENT

STATESVILLE 704-878-5305 (e1) MOORESVILLE 704-664-5281

IMPROVEMENT PERMIT / AUTHORIZATION TO CONSTRUCT / OPERATION PERMIT / EXISTING SYSTEM INSPECTION

PERMIT# 120874 PIN# ~~4822-40-4517.001~~ 4822404555 4822404555 DATE 6/11/04

OWNER OR CONTRACTOR Jeremy King PHONE: Business (704) 664-1300 Home (704) 592-2567

ADDRESS 135 Ella Kay Lane Statesville, NC 28677

LOCATION 115N TR Ella Kay Ln property at end (site across from Jordan's Texaco)

SUBDIVISION ~~—~~ BLOCK / SECTION ____ LOT 1 LOT AREA 1.3 SITE CLASS. PS DESIGN FLOW 360 L.T.A.R. 0.30 EXISTING

Septic Tank: 1000 Gallons; STB 620 Date 10-29-04

Pump Tank: 1000 Gallons; PT 144 Date 10-12-04

Pump Make: ZOELLER Model BN-153 Serial No. ____

Nitrification Field: No Fields 1 Square Feet 1200 Linear Feet 400 EX

No Lines 5 EX. Trench Width EX. Max Trench Bottom Depth EX. Gravel Depth EX.

☑ New System ☐ Repair System Type: I, II, (III), IV, V, VI

System Description: Pump Conventional

Repair System Description: LP Panel 50% red

Maintenance Agreement Required: ☐ Yes ☑ No

☑ House/Mod. Home No. Bedrooms 3

☐ Mobile Home No. Bathrooms 2

☐ Business No. Employees ____

☐ Other ____


☐ Slab ☐ Crawl Space ☑ Basement w/plumbing ☐ Basement wo/plumbing

Water Supply: ☑ Individual ☐ Public ☐ Community WELL


Comments/Conditions: (1) Install tanks according to sketch, pumping to existing septic tank (2) supply leads to go under drainage pattern to prevent future erosion ground pipe (3) Nema 4x box must be hooked up and sealed (4) Existing single-wide must be disconnected from existing system and removed from site

Comments/Conditions: SEPTIC TANK WITH RISERS INSTALLED USING "ZABEL" FILTER

INITIAL SITE SKETCH Scale 1" = 60'

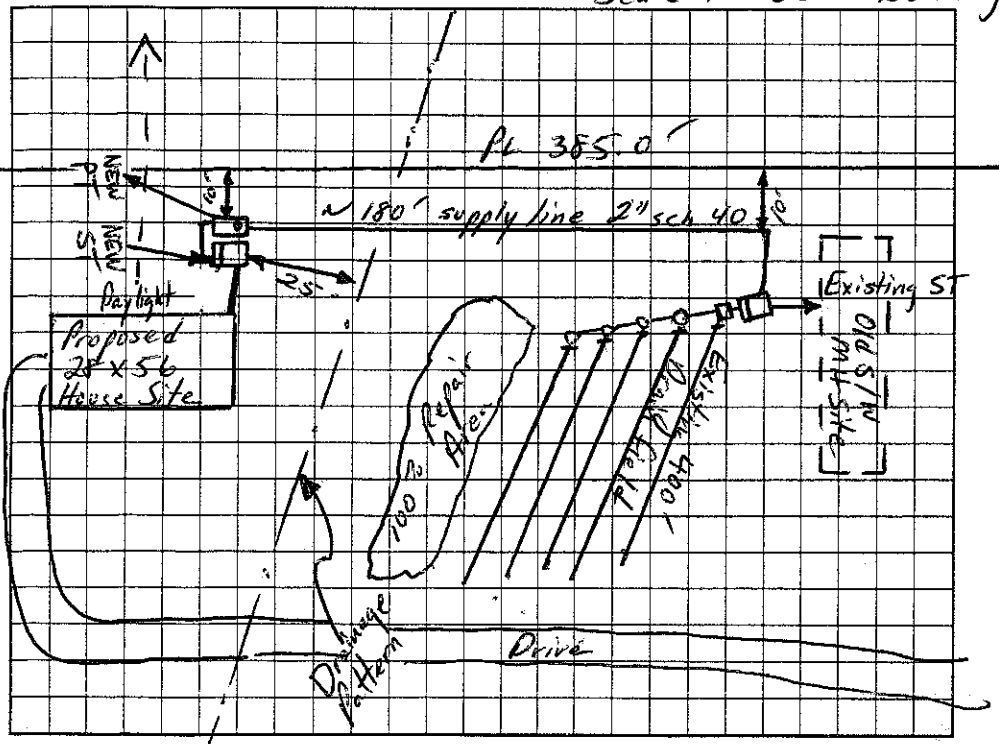

AS BUILT SKETCH

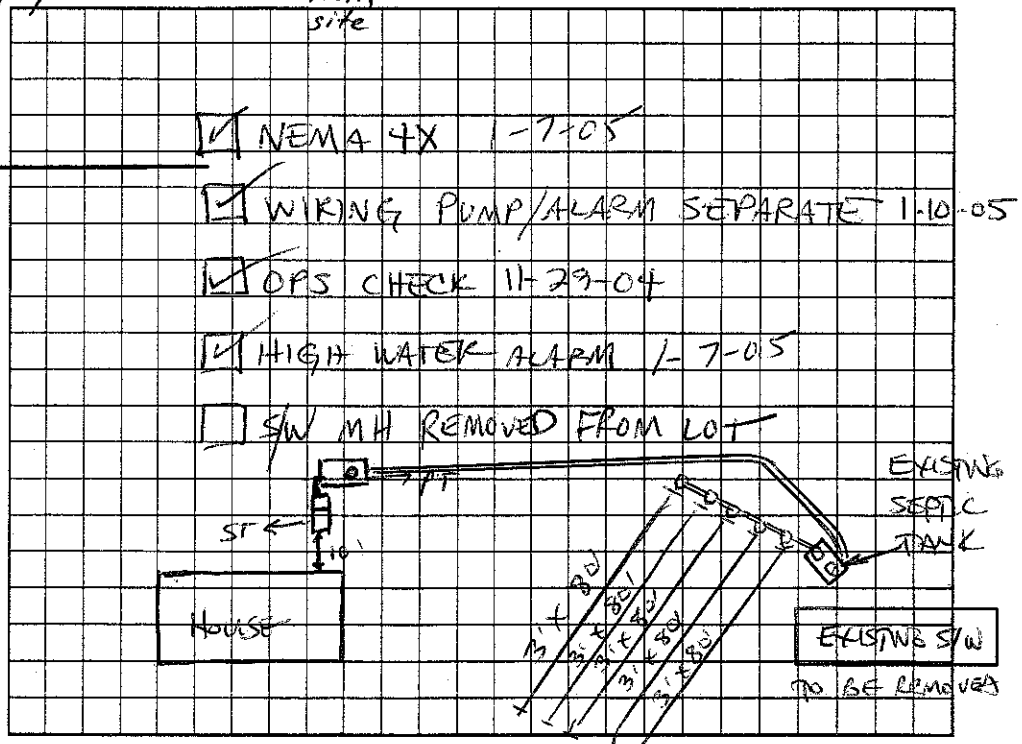

Permit can be suspended or revoked if any false information is supplied toward securing the permit/any unauthorized changes are made to the site/any unauthorized changes are made in the installation of the system. Improvement Permit with plat valid without expiration. Improvement Permit with site plan valid for sixty months. Authorization to Construct is valid for a period equal to that of Improvement Permit – not to exceed sixty months.

Signed: Jeremy King date 6/16/04 Installed by: NIXON'S BACKHOE

Improvement Permit by: Christopher M Shuler RS date 6-11-04 Operation Permit by: ~~STEVE~~ HEDRICK date 1-11-05

Authorization to Construct by: Christopher M Shuler RS date 6-11-04 Existing System Inspection by: ____ date ____

HEALTH DEPT. COPY: WHITE OWNER COPY (FINAL): YELLOW OWNER COPY (INITIAL): PINK

Family Division of Moore Ridge