IREDELL COUNTY HEALTH DEPARTMENT

Statesville Phone TR 3-7271 Mooresville Phone NO 3-1271

PERMIT TO INSTALL SEPTIC TANK

Permit NO. _____ Permit Date 6-16 19 66

Owner [illegible] RT 2 BOX 312 Address Owner - JL Hope

Installed By Prospect Church. Address N Iredell


Location of Property right off 115 - 2 miles on dirt 3rd dirt past Roy Tilley.

Tank		Capacity		Length of Lines		Fixtures	
Block	( )	800	( )	150'	( )	No. of Baths	( )
Precast	(✓)	900	(✓)	175'	( )	Dishwasher	( )
		1000	( )	200'	( )	Garbage Grdr.	( )
Load		1100	( )	225'	( )	Auto-Washer	( )
		1200	( )	250'	( )	Other _____	
		Other _____		Other _____			

NOTIFY HEALTH DEPARTMENT AT LEAST EIGHT HOURS BEFORE TANK IS TO BE INSPECTED.

Final Inspection _____ 19___ Approved ( ) Disapproved ( )

Remarks Mt fo washa - well 100ft.

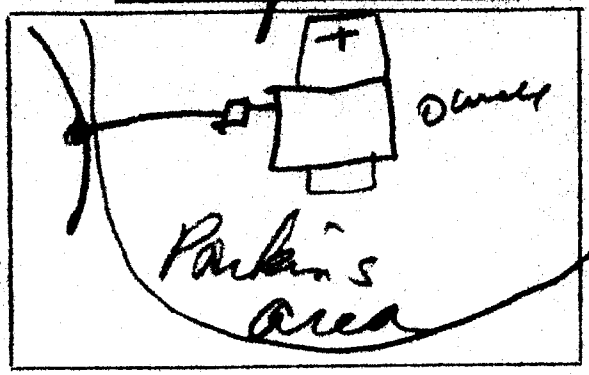

Sketch of Installation

R.J.
Sly Sgt.

Sanitarian