IREDELL COUNTY HEALTH DEPARTMENT

STATESVILLE 704-878-5305 MOORESVILLE 704-664-5281

IMPROVEMENT PERMIT / AUTHORIZATION TO CONSTRUCT / OPERATION PERMIT / EXISTING SYSTEM INSPECTION

PERMIT# 76493 PIN# 4822-95-4216 DATE 9-24-98

OWNER OR CONTRACTOR Steve Grant PHONE: Business _____ Home 592-2064

ADDRESS 290 Prospect Rd

LOCATION NC 115 North past Prospect Rd Jordans Texaco TR Prospect Rd 1½ mi left

SUBDIVISION _____ BLOCK / SECTION _____ LOT _____ LOT AREA 1.41 acres SITE CLASS. PS DESIGN FLOW 240 L.T.A.R. .3

Septic Tank: 1000 Gallons; STB 825 Date 9-1-98

Pump Tank: _____ Gallons; PT _____ Date _____

Pump Make: _____ Model _____ Serial No. _____

Nitrification Field: No Fields 1 Square Feet 840 Linear Feet 280

No Lines 4 Trench Width 36" Max Trench Bottom Depth 36" Gravel Depth 12"

☑ New System ☐ Repair System Type: I, II, III, IV, V, VI

System Description: Conv. Gravity

Repair System Description: " "

Maintenance Agreement Required: ☐ Yes ☑ No

☐ House/Mod. Home No. Bedrooms 2

☑ Mobile Home No. Bathrooms 2

☐ Business No. Employees ____

☐ Other _____

☐ Slab ☑ Crawl Space ☐ Basement w/plumbing ☐ Basement wo/plumbing

Water Supply: ☑ Individual ☐ Public ☐ Community


well next door

Comments:/Conditions:


Property line

Comments:/Conditions:

INITIAL SITE SKETCH

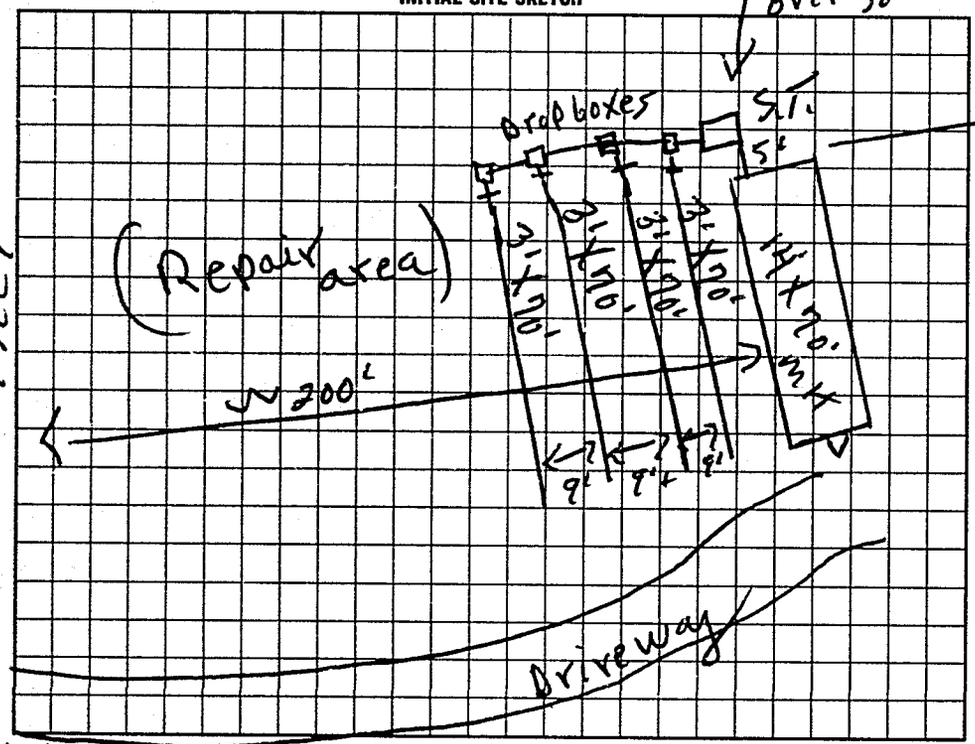

AS BUILT SKETCH

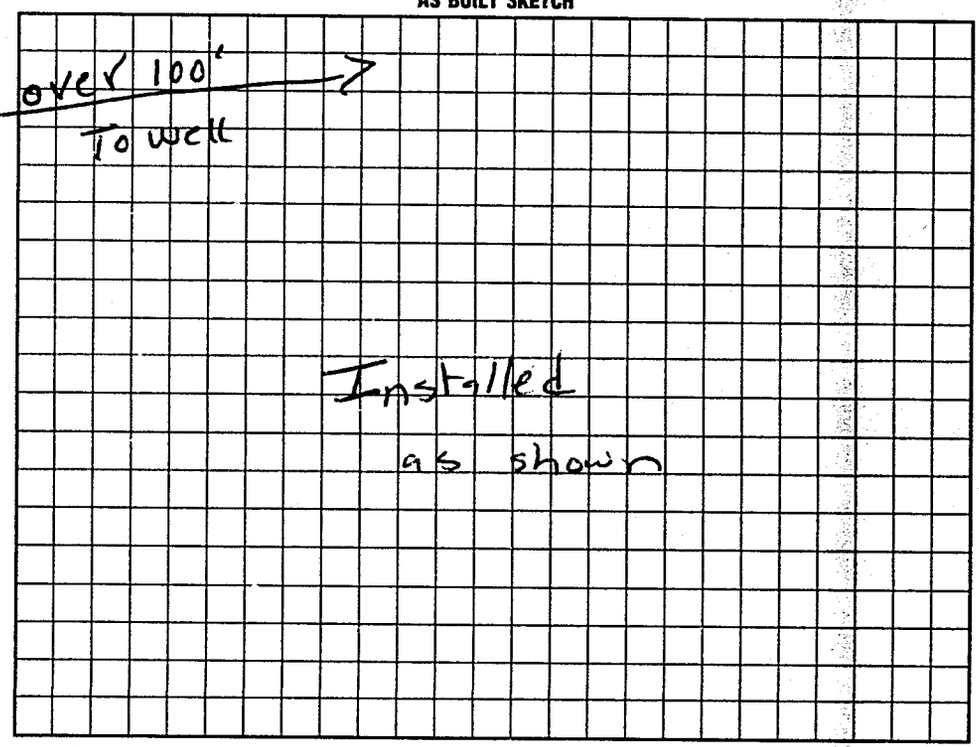

I understand that this permit can be suspended or revoked if any false information is supplied toward securing the permit/any unauthorized changes are made to the site/any unauthorized changes are made in the installation of the system. Improvement Permit with plat valid without expiration. Improvement Permit with site plan valid for sixty months. Authorization to Construct is valid for a period equal to that of Improvement Permit – not to exceed sixty months.

Signed: X Rachel S Grant date _____ Installed by: C&W

Improvement Permit by: P. C. Moore date 9-24-98 Operation Permit by: Mary C. Ostrom date 10-14-98

Authorization to Construct by: P. C. Moore date 9-24-98 Existing System Inspection by: _____ date _____

HEALTH DEPT. COPY WHITE INSPECTION COPY (FINAL). GREEN OWNER COPY (FINAL). YELLOW INSPECTION COPY (INITIAL). PINK OWNER COPY (INITIAL). GOLD

9 1 5 0 0