The proposed outbuilding Foundation addition does not appear to impact the existing septic system.
**NOTE: Connection to septic not approved at this time

R.S.

Date: 4-24-09
ICHD-Environmental Health Division

IREDELL COUNTY HEALTH DEPARTMENT STATESVILLE 704-878-5305 MOORESVILLE 704-664-5281
IMPROVEMENT PERMIT / AUTHORIZATION TO CONSTRUCT / OPERATION PERMIT / EXISTING SYSTEM INSP

PERMIT# 09171 PIN# 4822 95 4216 DATE 8-
OWNER OR CONTRACTOR STEVE GRANT PHONE Business 878-4310 Home 592-2069
ADDRESS 290 PROSPECT ROAD, STATESVILLE, NC 28625
LOCATION NC 115 North TO PROSPECT ROAD, 1.1 MILE ON LEFT AT BOX # 278
SUBDIVISION BLOCK / SECTION LOT LOT AREA AMPLE SITE CLASS PS DESIGN FLOW 360 LTAR 0.36

Septic Tank EXISTING Gallons, STB Date
Pump Tank Gallons, PT Date
Pump Make Model Serial No.
Notification Field: No Fields 1 Square Feet 360 Linear Feet 120
No Lines DNE Trench Width 36" Max Trench Bottom Depth 36" Gravel Depth 12"


☑ New System ☐ Repair System Type: I II III IV V
System Description: CONVENTIONAL GRAVITY
Repair System Description: CONV. GRAVITY
Maintenance Agreement Required: ☐ Yes ☐ No
☐ Slab ☐ Crawl Space ☐ Basement w/plumbing ☐ Basement w/o plumbing

☐ House/Mod Home No Bedrooms 3
☑ Mobile Home No Bathrooms 2
☐ Business No Employees
☐ Other

Comments/Conditions: INSTALL NEW 3' x 120' LINE (TOTAL) BY TYING INTO EXISTING DROP BOX AS SHOWN

Comments/Conditions:

INITIAL SITE SKETCH SCALE: 1" = 40'

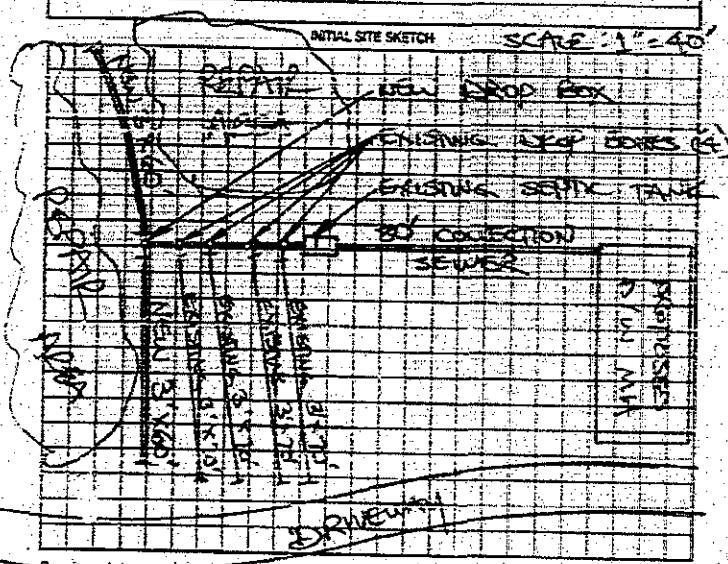

AS BUILT SKETCH

SYSTEM EXPANDED ACCORDING TO INITIAL SITE SKETCH

Permit can be suspended or revoked if any false information is supplied toward securing the permit any unauthorized changes are made to the site any unauthorized changes are made to the installation of the system.
Permit with plat valid without expiration. Improvement Permit with site plan valid for sixty months. Authorization to Construct is valid for a period equal to that of Improvement Permit – not to exceed sixty months.

Signed: [signature] date 8/19/00 Installed by: STATESVILLE BACKHOE SER
Improvement Permit by: STEVE HENDRICK date 3-19-00 Operation Permit by: STEVE HENDRICK date 9-
Authorization to Construct by: STEVE HENDRICK date 8-19-00 Existing System Inspection by: date

HEALTH DEPT. COPY WHITE OWNER COPY (FINAL) YELLOW OWNER COPY (INITIAL) PINK

JAN. 4, 1989 2:45