IREDELL COUNTY HEALTH DEPARTMENT

Statesville Office (704) 878-5305 Mooresville Office (704) 660-3625 PERMIT # 18145

IMPROVEMENT PERMIT / AUTHORIZATION TO CONSTRUCT / OPERATION PERMIT / EXISTING SYSTEM

PIN # 4822-95-8738.000

APPLICANT: James Patrick VanBarger APPLICANT ADDRESS: 244 Paddock Rd. Union Grove NC 28689

SITE ADDRESS: 1143 Aycock Rd. Statesville NC 28625 PHONE: 336-469-2089 ALT. PHONE: 704-592-4804

SITE DIRECTIONS: 115 N, TR Prospect Church Rd., TL Aycock, 1ST House on L

SUBDIVISION: — SECTION: — LOT # — LOT AREA: 7.8 Acre DESIGN FLOW: 360 GPD L.T.A.R.: .275 I / .3 R


Septic Tank	1000	(gal)	STB 760	Date	6/21/16	☐ New System ☐ Repair ☒ Expansion	System Type: I II (III) IV V VI	☒ Residence	No. Bedrooms 3
Pump Tank		(gal)	PT	Date		System Description:	25% Reduction - Gravity	☐ Business	No. Persons 6
Pump Make		Model		Serial #		Repair System Description:	25% Reduction - Pump	☐ Other	No. Employees
# Nitrification Fields	1	# Lines	6	Linear Ft:	328'	Maintenance Agreement Required:	☐ YES ☒ NO	☐ Slab	☒ Crawl Space
Trench Width	36"	Max. Trench Bottom Depth	* 25" *	Gravel Depth	N/A	☒ GRAVITY	☐ PRESSURE	☐ Basement w/ plumbing	☐ Basement w/o plumbing

Water Supply: ☒ Private ☐ Public ☐ Community


Comments / Conditions: Install & Drain - Crush & Fill Existing Tank. Maintain 50' From Any Well. 25" Max Trench Bottom Depth. Follow All NC Septic Rules. Grade So That No Drainage Stays on Septic Area

* Final Plans Must Be Submitted Prior To Issuance of AC. *

INITIAL SITE SKETCH

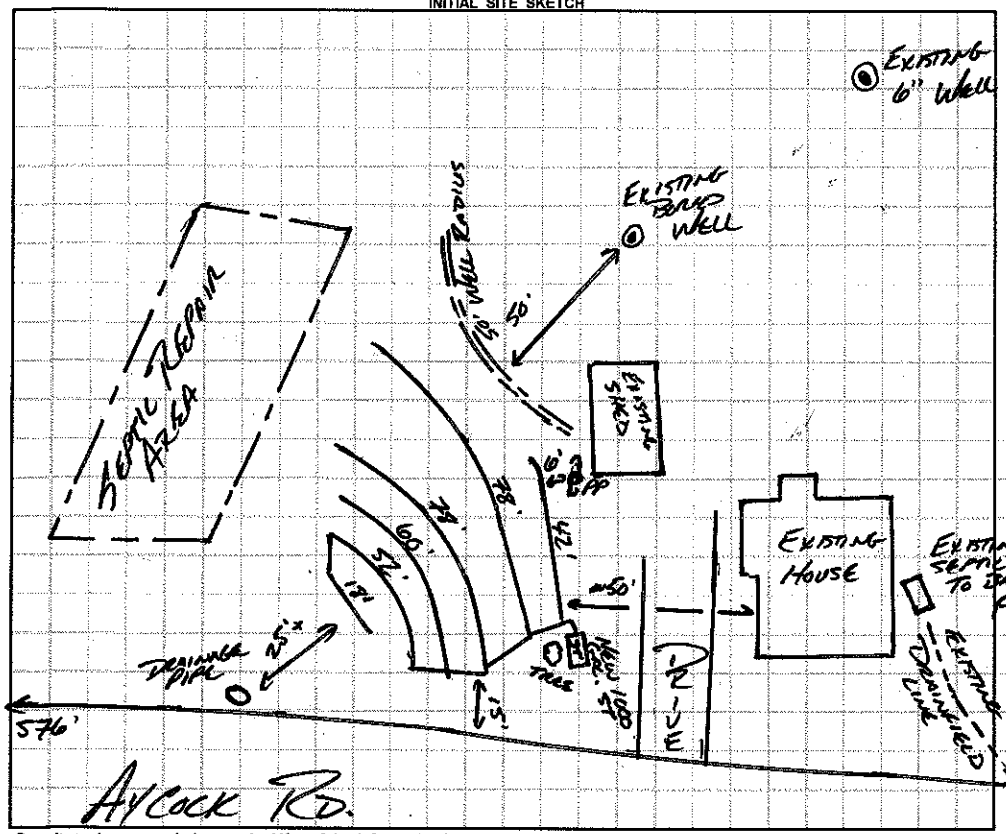

AS BUILT SKETCH

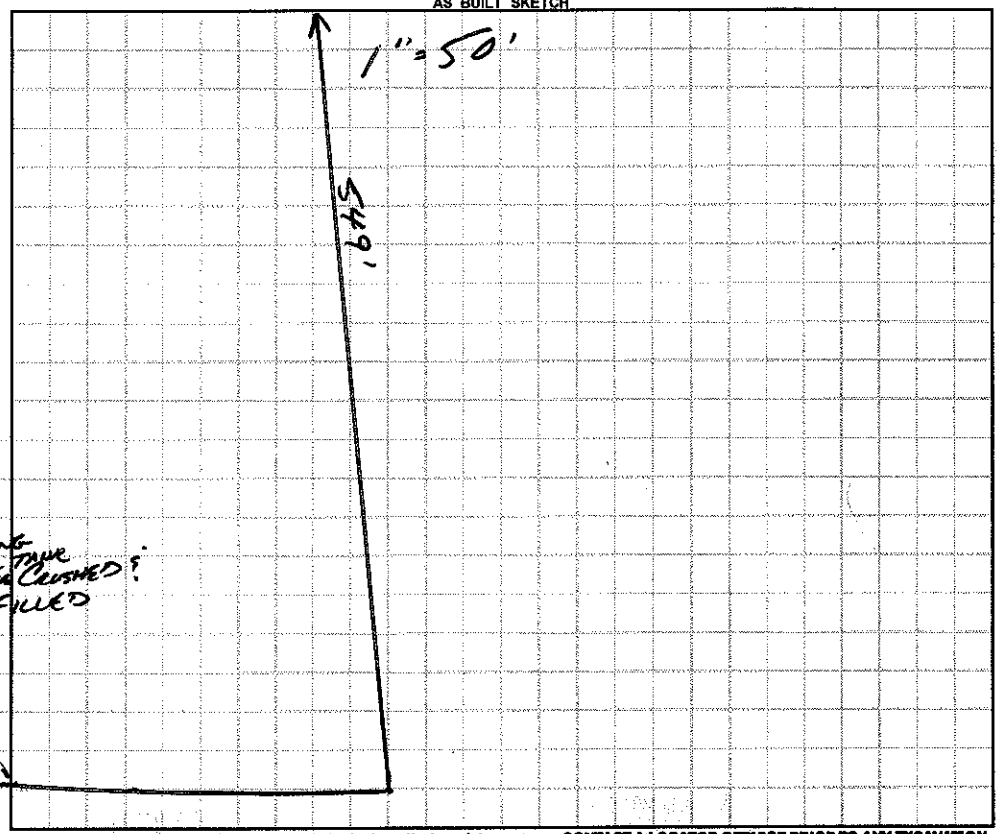

Permit can be suspended or revoked if any false information is supplied toward securing the permit / any unauthorized changes are made to the site / any unauthorized changes are made in the installation of the system. **CONTACT A LOCATOR SERVICE PRIOR TO ANY EXCAVATION**

☐ **IMPROVEMENT PERMIT** *with plat valid without expiration.* ☒ **IMPROVEMENT PERMIT** *with site plan valid for 60 mos.* ☒ **AUTHORIZATION TO CONSTRUCT** *valid for period equal to IMPROVEMENT PERMIT--not to exceed 60 mo.*

Owner / Applicant Signature: Date: 7-19-16

IMPROVEMENT PERMIT by: APPROVED Date: JUL 12 2016

AUTHORIZATION TO CONSTRUCT by: Date: 7/15/16

Installed by: Date: 8/29/16

OPERATION PERMIT by: Date:

Existing System Inspected by:

Health Dept. Copy - WHITE Applicant (Final Approval) - YELLOW Applicant (Conditional Approval) - PINK