IREDELL COUNTY HEALTH DEPARTMENT

STATESVILLE 704-878-5305 MOORESVILLE 704-664-5281

IMPROVEMENT PERMIT / AUTHORIZATION TO CONSTRUCT / OPERATION PERMIT / EXISTING SYSTEM INSPECTION

DATE 11-28-00

PERMIT# 092973 PIN# 4822 99 5236 (PT) PHONE: Business Home 592-5043

OWNER OR CONTRACTOR LARRY SHOEMAKER

ADDRESS 294 AYCOCK ROAD, STATESVILLE NC 28625

LOCATION NC 115 N, TR PROSPECT CH. RD, TL AYCOCK ROAD 0.8 MILE ON RIGHT.

SUBDIVISION BLOCK / SECTION LOT LOT AREA 2.14 ACRES SITE CLASS PS DESIGN FLOW 360 L.T.A.R. 0.30 GPD/FT²

Septic Tank: 1000 Gallons; STB 1012 Date 8-18-00

Pump Tank: Gallons; PT Date

Pump Make: Model Serial No.

Nitrification Field: No Fields 1 Square Feet 1200 Linear Feet 400

No Lines SIX Trench Width 36" Max Trench Bottom Depth 36" Gravel Depth 12"

✓ New System ☐ Repair System Type: I II III IV V VI

System Description: CONV. GRAVITY

Repair System Description: CONV. GRAVITY

Maintenance Agreement Required: ☐ Yes ✓ No

✓ House/Mod. Home No. Bedrooms 3

☐ Mobile Home No. Bathrooms 2

☐ Business No. Employees

☐ Other

☐ Slab ✓ Crawl Space ☐ Basement w/plumbing ☐ Basement wo/plumbing


Water Supply: ✓ Individual ☐ Public ☐ Community

WELL


Comments/Conditions: KEEP SYSTEM MINIMUM 100 FEET FROM WELL

Comments/Conditions: SEPTIC TANK W/ RISERS INSTALLED USING "POLYLOK" FILTER

INITIAL SITE SKETCH

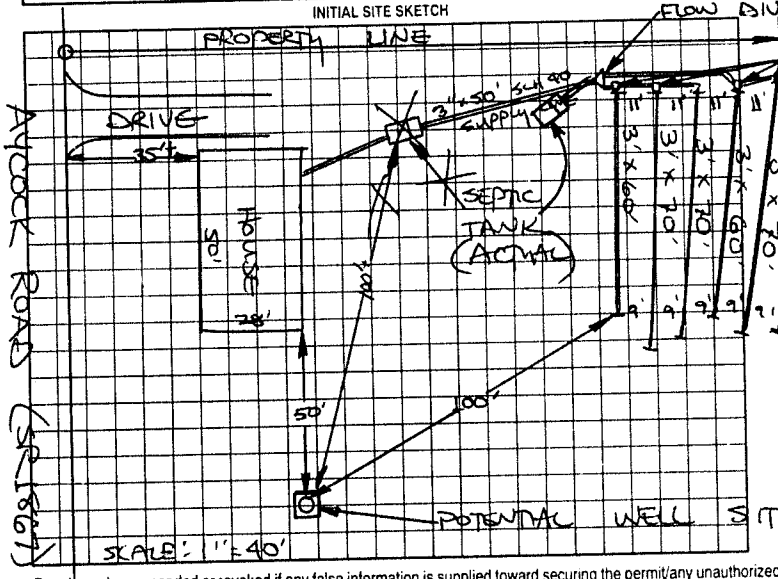

AS BUILT SKETCH

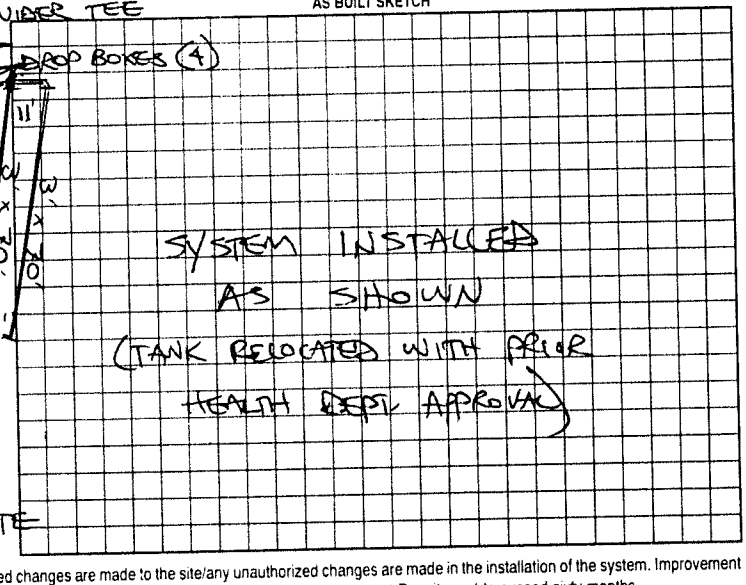

Permit can be suspended or revoked if any false information is supplied toward securing the permit/any unauthorized changes are made to the site/any unauthorized changes are made in the installation of the system. Improvement Permit with plat valid without expiration. Improvement Permit with site plan valid for sixty months. Authorization to Construct is valid for a period equal to that of Improvement Permit – not to exceed sixty months.

Signed: Larry Shoemaker date 11-28-00 Installed by: DAVID YOUNTZ

Improvement Permit by: STEVE HEDRICK date 11-28-00 Operation Permit by: STEVE HEDRICK date 5-9-01

Authorization to Construct by: STEVE HEDRICK date 11-28-00 Existing System Inspection by: date

HEALTH DEPT COPY WHITE OWNER COPY (FINAL) YELLOW OWNER COPY (INITIAL) PINK