IREDELL COUNTY HEALTH DEPARTMENT

STATESVILLE 704-878-5305 MOORESVILLE 704-664-5281

IMPROVEMENT PERMIT / AUTHORIZATION TO CONSTRUCT / OPERATION PERMIT / EXISTING SYSTEM INSPECTION

PERMIT # 159313 PIN # 4823-08-0261 DATE 17 December 09

OWNER or APPLICANT Michael Wright SR PHONE: ~~Business~~ Cell (704) 928-9261 Home:

OWNER or APPLICANT ADDRESS 160 Sandburg Rd. Union Grove, NC

LOCATION / DIRECTIONS Hwy 115 N past Hwy 901 TL Sandburg - First Drive on Rt.

SUBDIVISION BLOCK / SECTION LOT # LOT AREA 1.5Ac± DESIGN FLOW 240 gpd L.T.A.R. 0.3 gal/sf/ft

Septic Tank Exist. Gallons: STB Date

Pump Tank Gallons: PT Date

Pump Make Model Serial #

Nitrification Field No Fields No Lines Linear Feet

Trench Width Max. Trench Bottom Depth Gravel Depth

☐ New System ☐ Repair ☐ Expansion System Type I (II) III IV V VI

System Description: Existing

Repair System Description:

Maintenance Agreement Required ☐ YES ☐ NO

☐ GRAVITY ☐ PRESSURE

☑ Residence No. Bedrooms 2

☐ Business No. Persons

☐ Other No. Employees

☐ Slab ☑ Crawl Space

☐ Basement w/plumbing ☐ Basement w/o plumbing

Water Supply: ☑ Private ☐ Public ☐ Community

Comments / Conditions


Comments / Conditions

Keep 25'± from well

Keep 5'± from septic tank & system

INITIAL SITE SKETCH

AS BUILT SKETCH

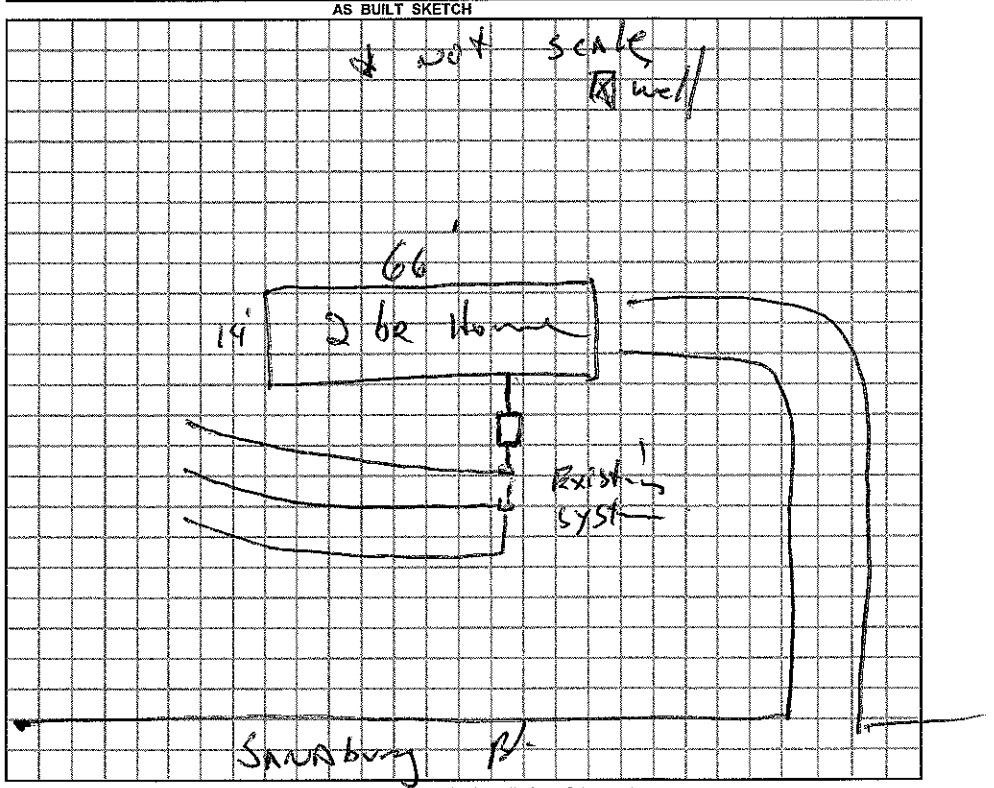

Permit can be suspended or revoked if any false information is supplied toward securing the permit / any unauthorized changes are made to the site / any unauthorized changes are made in the installation of the system.

☐ *IMPROVEMENT PERMIT w / plat valid without expiration.* ☐ *IMPROVEMENT PERMIT w / site plan valid for 60 mos.* ☐ *AUTHORIZATION TO CONSTRUCT valid for period equal to IMPROVEMENT PERMIT-not to exceed 60 mo.*

Owner / Applicant Signature: Date

Improvement Permit by: Date

Authorization to Construct by: Date

YOU SHOULD CONTACT A LOCATOR SERVICE PRIOR TO ANY EXCAVATION.

Installed by:

Operation Permit by: Date:

Existing System Inspected by: J. Wright, R.S. Date: 17 Dec 09

WHITE COPY Environmental Health YELLOW COPY (Final) Owner / Applicant PINK COPY (Initial) Owner / Applicant