48969

IREDELL COUNTY HEALTH DEPARTMENT

STATESVILLE 704-878-5305 MOORESVILLE 704-664-5281

IMPROVEMENT PERMIT / CERTIFICATE OF COMPLETION / OPERATION PERMIT / EXISTING SYSTEM INSPECTION

PROPERTY DESCRIPTION NO. 17123 DATE 9/30/93 TAX MAP NO. 15J-A-16

OWNER OR CONTRACTOR SCOTT WILLIAMS PHONE: Business Home PT 592-5922

ADDRESS RT. 1, BOX 268 UNION GROVE NC 28689

LOCATION NC 115 N, TL SANDBURG ROAD MH ON (R) ~ 0.3 MILE

SUBDIVISION BLOCK / SECTION LOT 1 LOT AREA 1.523 ACRES SITE CLASS PS L.T.A.R. 0.30 GPD/FT²

Water Supply: ☑ Individual ☐ Community ☐ Public WELL TO BE LOCATED

Septic Tank: 1000 Gallons; STB 782 Date 9/1/93

Pump Tank: Gallons; PT Date

Nitrification Field: No Fields 1 Square Feet 1200' Linear Feet 400'

No Lines 3 Trench Width 36" Trench Depth 30"-36" Gravel Depth 12"

☑ New System ☐ Repair System Type: I, II, III, IV, V, VI

System Description: CONV. GRAVITY

Repair System Description: CONV. GRAVITY

Maintenance Agreement Required: ☐ Yes ☑ No

☐ House/Mod. Home ☑ Mobile Home ☐ Business ☐ Other PLANNED FOR FUTURE 3BR

No. Bedrooms 2 No. Bathrooms 2 No. Employees

Garbage Disposal: ☐ Yes ☑ No

Auto. Dishwasher: ☑ Yes ☐ No


Auto. Washing Machine: ☑ Yes ☐ No

Other

☐ Slab ☑ Crawl Space ☐ Basement w/plumbing ☐ Basement wo/plumbing

Comments ① KEEP SYSTEM MINIMUM 5' FROM MH, 10' FROM PROPERTY LINE, 100' FROM WELL ② INSTALL LINES ON CONTOUR, NO DEEPER THAN 36", 9' APART ON CENTER

INITIAL SITE SKETCH

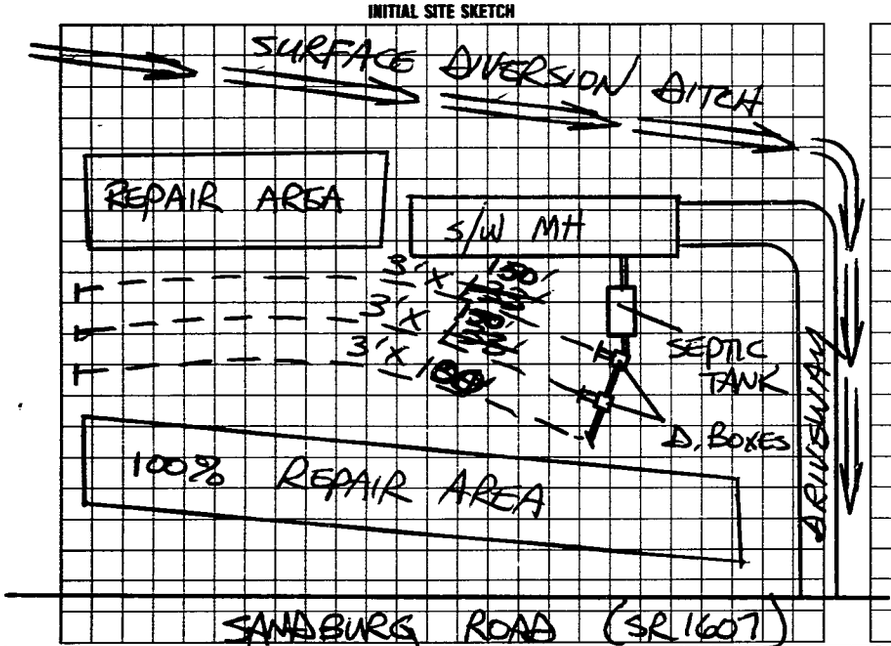

AS BUILT SKETCH

SYSTEM INSTALLED ACCORDING TO INITIAL SITE SKETCH

I understand that this permit can be suspended or revoked if any false information is supplied toward securing the permit/any unauthorized changes are made to the site/any unauthorized changes are made in the installation of the system. Improvement Permit is valid for 60 months from date of issuance.

Signed: X Scott Williams

Improvement Permit by: STEVE HEDRICK date 9/30/93

Existing System Inspection by: date

Installed by: JEFF HURLBUT

Certificate of Completion by: STEVE HEDRICK date 10/6/93

Operation Permit by: date

HEALTH DEPT. COPY: WHITE INSPECTION COPY (FINAL): GREEN OWNER COPY (FINAL): YELLOW INSPECTION COPY (INITIAL): PINK OWNER COPY (INITIAL): GOLD