(owner) Kathy + Gary Potts

IREDELL COUNTY HEALTH DEPARTMENT

STATESVILLE 704-878-5305 (C1) MOORESVILLE 704-664-5281

(E) **IMPROVEMENT PERMIT / AUTHORIZATION TO CONSTRUCT / OPERATION PERMIT / EXISTING SYSTEM INSPECTION**

PERMIT# 107177 PIN# ~~4823-11-9828.8~~ 4823-11-7668 (1/1/09 ad) DATE 7/22/02

OWNER OR CONTRACTOR RURAL AFFORDABLE HOUSING PHONE: Business 924-8942 Home

ADDRESS 1321C DIXIE DRIVE STATESVILLE NC 28677

LOCATION 115 (N) - TR WESTGLOW - KAMMERER ON RT

SUBDIVISION WESTGLOW BLOCK / SECTION LOT 8 LOT AREA .68AC SITE CLASS. PS DESIGN FLOW 360 GPD L.T.A.R. .36-00/F02

Septic Tank: 1000 Gallons; STB 160 Date 11-1-02 ☑ New System ☐ Repair System Type: I, II, (III), IV, V, VI

Pump Tank: Gallons; PT Date System Description: GRAVITY INNOVATIVE

Pump Make: Model Serial No. Repair System Description: LP PANEL

Nitrification Field: No Fields 1 Square Feet 900 Linear Feet 300 Maintenance Agreement Required: ☐ Yes ☑ No

No Lines 5@60' Trench Width 36" Max Trench Bottom Depth 36" Gravel Depth N/A

☑ House/Mod. Home No. Bedrooms 3
☐ Mobile Home No. Bathrooms 2
☐ Business No. Employees
☐ Other

☐ Slab ☐ Crawl Space ☐ Basement w/plumbing ☐ Basement wo/plumbing


Water Supply: ☑ Individual ☐ Public ☐ Community

Comments:/Conditions:


1"=50'

Comments:/Conditions: SEPTIC TANK WITH MARKER INSTALLED USING "ZABEL" FILTER

INITIAL SITE SKETCH

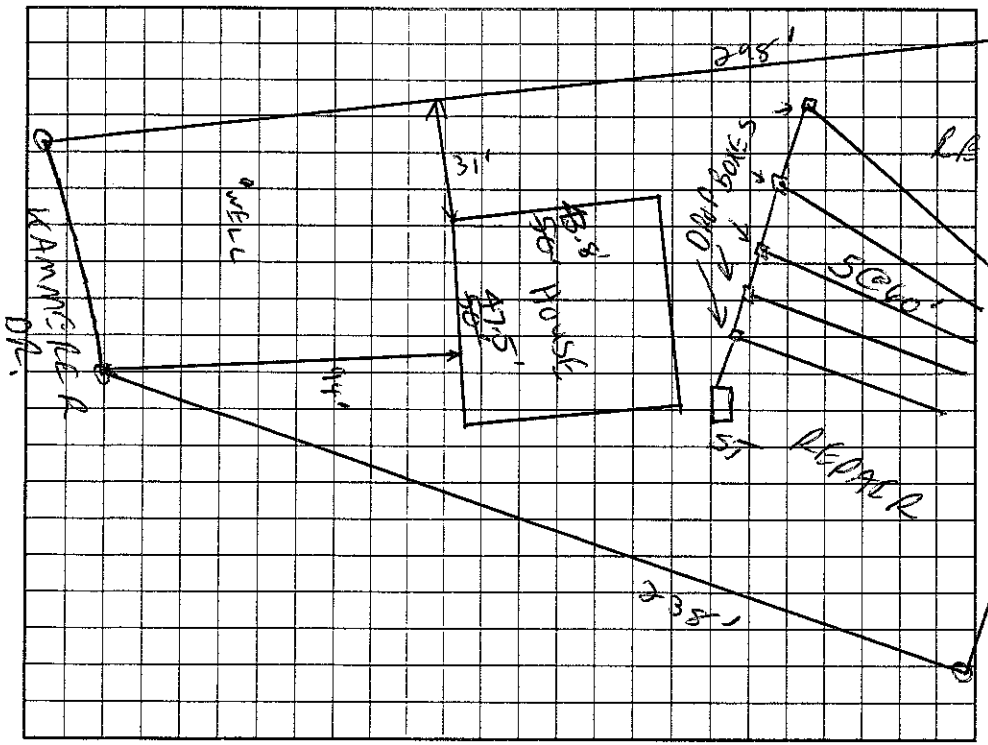

AS BUILT SKETCH

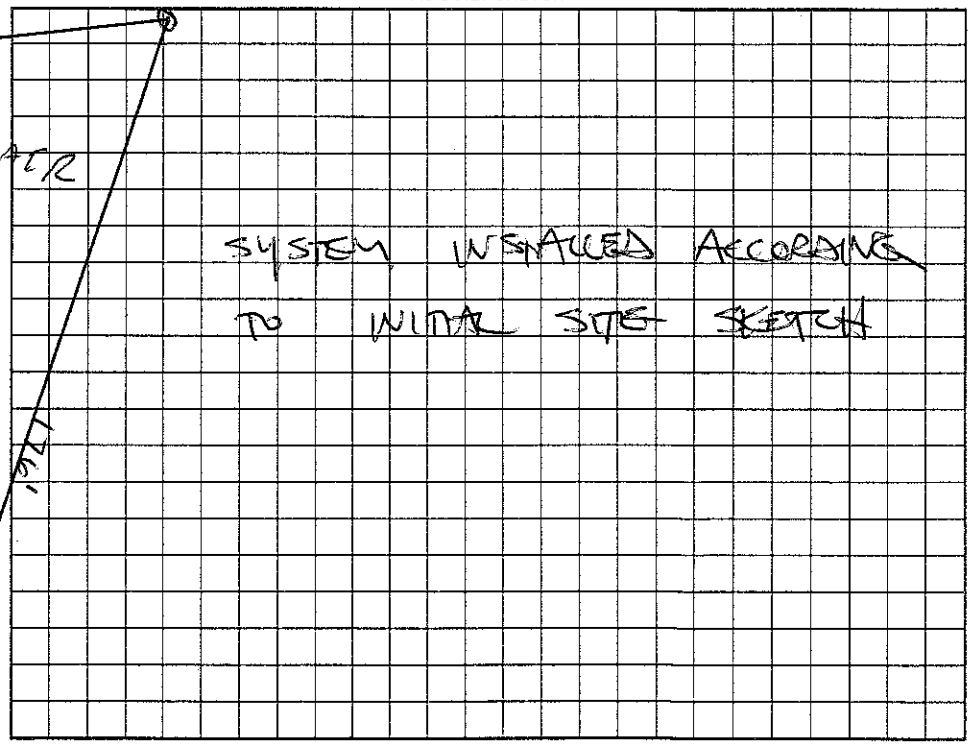

Permit can be suspended or revoked if any false information is supplied toward securing the permit/any unauthorized changes are made to the site/any unauthorized changes are made in the installation of the system. Improvement Permit with plat valid without expiration. Improvement Permit with site plan valid for sixty months. Authorization to Construct is valid for a period equal to that of Improvement Permit – not to exceed sixty months.

Signed: date 8/22/02 Installed by: DAVID UMBARGER

Improvement Permit by: CS date 7/22/02 Operation Permit by: STEVE HENDRICK date 1-15-03

Authorization to Construct by: STEVE HENDRICK date 9-4-02 Existing System Inspection by: date

HEALTH DEPT. COPY: WHITE OWNER COPY (FINAL): YELLOW OWNER COPY (INITIAL): PINK