IREDELL COUNTY HEALTH DEPARTMENT

STATESVILLE 704-878-5305 (C1) MOORESVILLE 704-664-5281

IMPROVEMENT PERMIT / AUTHORIZATION TO CONSTRUCT / OPERATION PERMIT / EXISTING SYSTEM INSPECTION

(C1)

PERMIT# 107176 PIN# ~~4823-11-9835.7~~ 4823-11-7785 DATE 7/22/02

OWNER OR CONTRACTOR RURAL AFFORDABLE HOUSING PHONE: Business 924-8942 Home

ADDRESS 1321-C DIXIE DRIVE STATESVILLE NC 28677

LOCATION 115 (N) - TR WESTGLOW - TR KAMMERER ON RT

SUBDIVISION WESTGLOW BLOCK / SECTION LOT 7 LOT AREA .53AC SITE CLASS PS DESIGN FLOW 360 GPD L.T.A.R. .36 GPD/FT²

Septic Tank: 1000 Gallons; STB 1160 Date 9-5-02

Pump Tank: Gallons; PT Date

Pump Make: Model Serial No.

Nitrification Field: No Fields 1 Square Feet 900 Linear Feet 300

No Lines 5 @ 60' Trench Width 36" Max Trench Bottom Depth ~~30'~~ 30"

☑ New System ☐ Repair System Type: I, II, (III) IV, V, VI

System Description: GRAVITY INNOVATIVE

Repair System Description: LP PANEL

Maintenance Agreement Required: ☐ Yes ☑ No

Gravel Depth N/A

☑ House/Mod. Home No. Bedrooms 3

☐ Mobile Home No. Bathrooms 2

☐ Business No. Employees

☐ Other


☐ Slab ☑ Crawl Space ☐ Basement w/plumbing ☐ Basement wo/plumbing

Water Supply: ☑ Individual ☐ Public ☐ Community

Comments:/Conditions:

Comments:/Conditions: (1) SEPTIC TANK WITH MARKER INSTALLED USING "ZABEL" FILTER (2) SYSTEM INSTALLED OUT OF CONTOUR EXCEEDING 30" DEEP - BUT AS DESIGNED ON INITAL SITE SKETCH

INITIAL SITE SKETCH

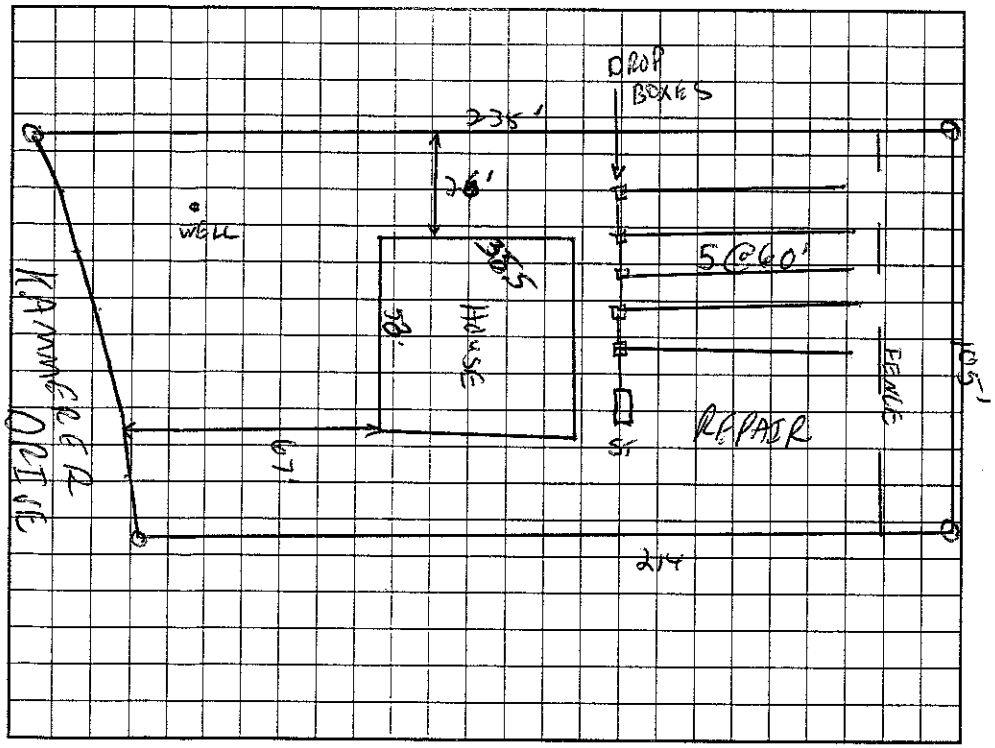

AS BUILT SKETCH

SKETCH

SYSTEM INSTALLED ACCORDING TO INITAL SITE SKETCH

Permit can be suspended or revoked if any false information is supplied toward securing the permit/any unauthorized changes are made to the site/any unauthorized changes are made in the installation of the system. Improvement Permit with plat valid without expiration. Improvement Permit with site plan valid for sixty months. Authorization to Construct is valid for a period equal to that of Improvement Permit – not to exceed sixty months.

Signed: [signature] date 8/12/02 Installed by: DAVID UMBARGER

Improvement Permit by: C. [signature] S date 7/22/02 Operation Permit by: STEVE HENDRICK date 1-15-03

Authorization to Construct by: STEVE HENDRICK date 9-4-02 Existing System Inspection by: date

HEALTH DEPT. COPY: WHITE OWNER COPY (FINAL): YELLOW OWNER COPY (INITIAL): PINK