IREDELL COUNTY HEALTH DEPARTMENT

STATESVILLE 704-878-5305 MOORESVILLE 704-664-5281

IMPROVEMENT PERMIT / AUTHORIZATION TO CONSTRUCT / OPERATION PERMIT / EXISTING SYSTEM INSPECTION

PERMIT# 107175 PIN# 4823117852 DATE 7/22/02

OWNER OR CONTRACTOR RURAL AFFORDABLE HOUSING PHONE: Business 924-8442 Home

ADDRESS 1321C DIXIE DRIVE STATESVILLE 28677

LOCATION 115(N) TR WEST GLOW - TR KANNEER - ON RT

SUBDIVISION WESTGLOW BLOCK / SECTION LOT 6 LOT AREA .52AC SITE CLASS. PS DESIGN FLOW 360GPD L.T.A.R. .30GPD/FT²

Septic Tank: 1000 Gallons; STB 160 Date 11-12-03
Pump Tank: Gallons; PT Date
Pump Make: Model Serial No.
Nitrification Field: No Fields 1 Square Feet 900 Linear Feet 300
No Lines 5@60' Trench Width 36" Max Trench Bottom Depth 36" Gravel Depth N/A

☑ New System ☐ Repair System Type: I, II, III, IV, V, VI
System Description: GRAVITY INNOVATIVE
Repair System Description: PUMP PANEL
Maintenance Agreement Required: ☐ Yes ☑ No


☑ House/Mod. Home No. Bedrooms 3
☐ Mobile Home No. Bathrooms 2
☐ Business No. Employees
☐ Other
☐ Slab ☑ Crawl Space ☐ Basement w/plumbing ☐ Basement wo/plumbing

Water Supply: ☑ Individual ☐ Public ☐ Community

Comments:/Conditions: HOUSE PLANS APPROVED ON 9-18-03, HOUSE IS 54'X27', KEEP BACK OF HOUSE IN SAME LOCATION ~~BACK OF HOUSE SHOWN ON SITE PLAN~~ BUT HOUSE IS CENTERED

Comments:/Conditions: WHERE IT IS 24' OFF BOTH P/L, SEPTIC SYSTEM WILL REMAIN UNALTERED, ① CHAMBERS ② ZABEL FILTER ③ INSTALLED 9-18-03 ACCORDING TO SKETCH.

INITIAL SITE SKETCH 1"=50'

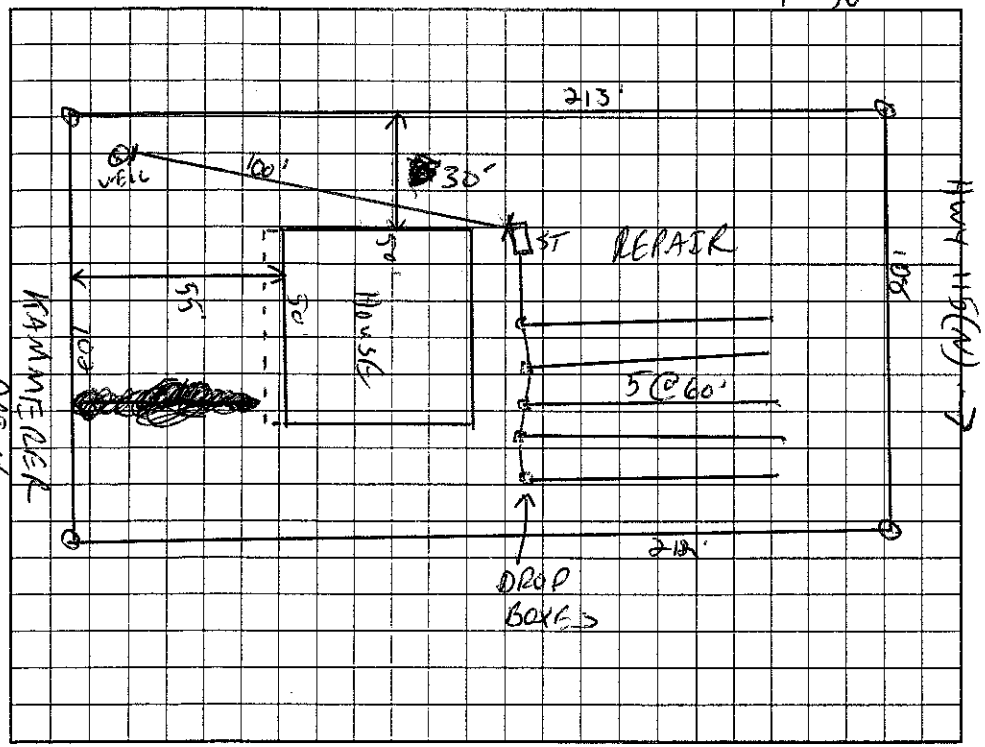

AS BUILT SKETCH

Permit can be suspended or revoked if any false information is supplied toward securing the permit/any unauthorized changes are made to the site/any unauthorized changes are made in the installation of the system. Improvement Permit with plat valid without expiration. Improvement Permit with site plan valid for sixty months. Authorization to Construct is valid for a period equal to that of Improvement Permit – not to exceed sixty months.

Signed: date Installed by: Umbarger Backhoe

Improvement Permit by: C. KS date 7/22/02 Operation Permit by: Christopher M. Merrill, R.S. date 2-23-04

Authorization to Construct by: KS date 9-18-03 Existing System Inspection by: date

HEALTH DEPT. COPY: WHITE OWNER COPY (FINAL): YELLOW OWNER COPY (INITIAL): PINK