IREDELL COUNTY HEALTH DEPARTMENT

STATESVILLE 704-878-5305 MOORESVILLE 704-664-5281

IMPROVEMENT PERMIT / AUTHORIZATION TO CONSTRUCT / OPERATION PERMIT / EXISTING SYSTEM INSPECTION

CI

PERMIT# 10718 PIN# ~~4523119828.9~~ 4823-11-8449 DATE 7/22/02

OWNER OR CONTRACTOR RURAL AFFORDABLE HOUSING PHONE: Business 924-8942 Home

ADDRESS 1321 DIXIE DRIVE - STATESVILLE NC 28625

LOCATION 115(N) - TR WESTGLOW - TR KAMMERER DRIVE - ON RT

SUBDIVISION WESTGLOW BLOCK / SECTION - LOT 9 LOT AREA .97AC SITE CLASS PS DESIGN FLOW 360GPD L.T.A.R. .256GPD/FT²

Septic Tank: 1000 Gallons; STB 160 Date 7-14-03
Pump Tank: Gallons; PT Date
Pump Make: Model Serial No.
Nitrification Field: No Fields 1 Square Feet 1440 Linear Feet 480
No Lines 5 Trench Width 36" Max Trench Bottom Depth 24" Gravel Depth 12"

☑ New System ☐ Repair System Type: I II III IV V VI
System Description: GRAVITY CONVENTIONAL
Repair System Description: SAME
Maintenance Agreement Required: ☐ Yes ☑ No


☑ House/Mod. Home No. Bedrooms 3
☐ Mobile Home No. Bathrooms 3
☐ Business No. Employees
☐ Other
☐ Slab ☑ Crawl Space ☐ Basement w/plumbing ☐ Basement wo/plumbing

Water Supply: ☑ Individual ☐ Public ☐ Community


Comments:/Conditions:

Comments:/Conditions: 2ABLE FILTER & MARKER INSTALLED

INITIAL SITE SKETCH 1"=50'

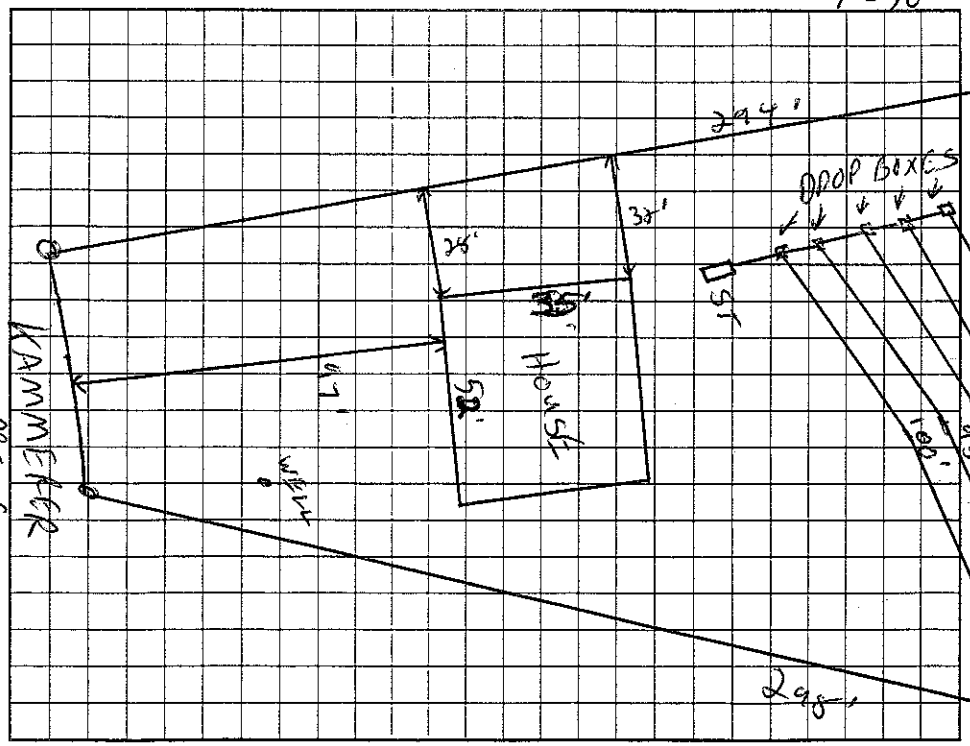

AS BUILT SKETCH

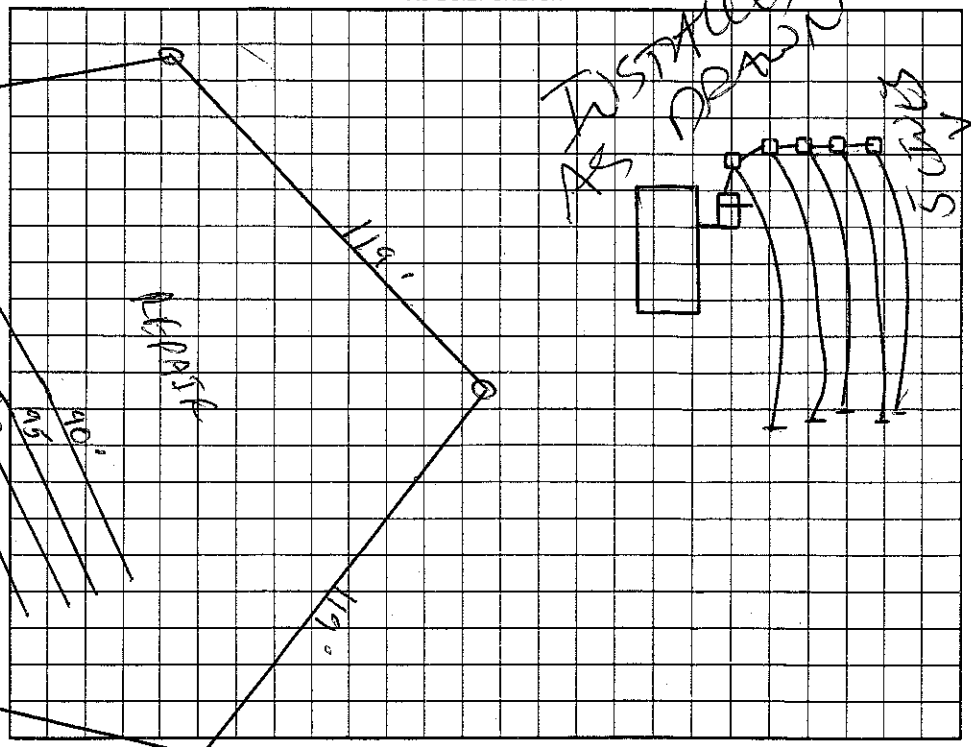

Permit can be suspended or revoked if any false information is supplied toward securing the permit/any unauthorized changes are made to the site/any unauthorized changes are made in the installation of the system. Improvement Permit with plat valid without expiration. Improvement Permit with site plan valid for sixty months. Authorization to Construct is valid for a period equal to that of Improvement Permit – not to exceed sixty months.

Signed: date 7/22/02 Installed by: DANIEL LOMBARDOZZI

Improvement Permit by: C. RS date 7/22/02 Operation Permit by: RS date 8-29-03

Authorization to Construct by: STEVE HEDRICK date 6-3-03 Existing System Inspection by: date

HEALTH DEPT. COPY: WHITE OWNER COPY (FINAL): YELLOW OWNER COPY (INITIAL): PINK