IREDELL COUNTY HEALTH DEPARTMENT

STATESVILLE 704-878-5305 MOORESVILLE 704-664-5281

IMPROVEMENT PERMIT / AUTHORIZATION TO CONSTRUCT / OPERATION PERMIT / EXISTING SYSTEM INSPECTION

PERMIT# 107151 PIN# 4823 11 ~~9828.10~~ 9487 DATE 7/23/02

OWNER OR CONTRACTOR RURAL AFFORDABLE HOUSING PHONE: Business 924-8942 Home

ADDRESS 1321C DIXIE DR STATESVILLE NC 28677

LOCATION 115(N) - TR WESTGLOW - TR KAMMERER - ON RT NEAR END

SUBDIVISION WESTGLOW BLOCK / SECTION LOT 10 LOT AREA .76AC SITE CLASS. RS DESIGN FLOW 360GPD L.T.A.R. .36 AC/FT

Septic Tank: 1000 Gallons; STB 1600 Date 12-2-03

Pump Tank: Gallons; PT Date

Pump Make: Model Serial No.

Nitrification Field: No Fields 1 Square Feet 1200 Linear Feet 400

No Lines 3@133' Trench Width 36" Max Trench Bottom Depth 36" Gravel Depth 12"

☑ New System ☐ Repair System Type: I (II) III IV V VI

System Description: GRAVITY CONVENTIONAL

Repair System Description: SAME

Maintenance Agreement Required: ☐ Yes ☑ No

~~☐ House/Mod. Home~~ No. Bedrooms 3

☐ Mobile Home No. Bathrooms 2

☐ Business No. Employees

☐ Other


☐ Slab ☑ Crawl Space ☐ Basement w/plumbing ☐ Basement wo/plumbing

Water Supply: ~~☑ Individual~~ ☐ Public ☐ Community

Comments:/Conditions:

Comments:/Conditions: ① ZABEL FILTER ② #5 STONE

1"=50' INITIAL SITE SKETCH

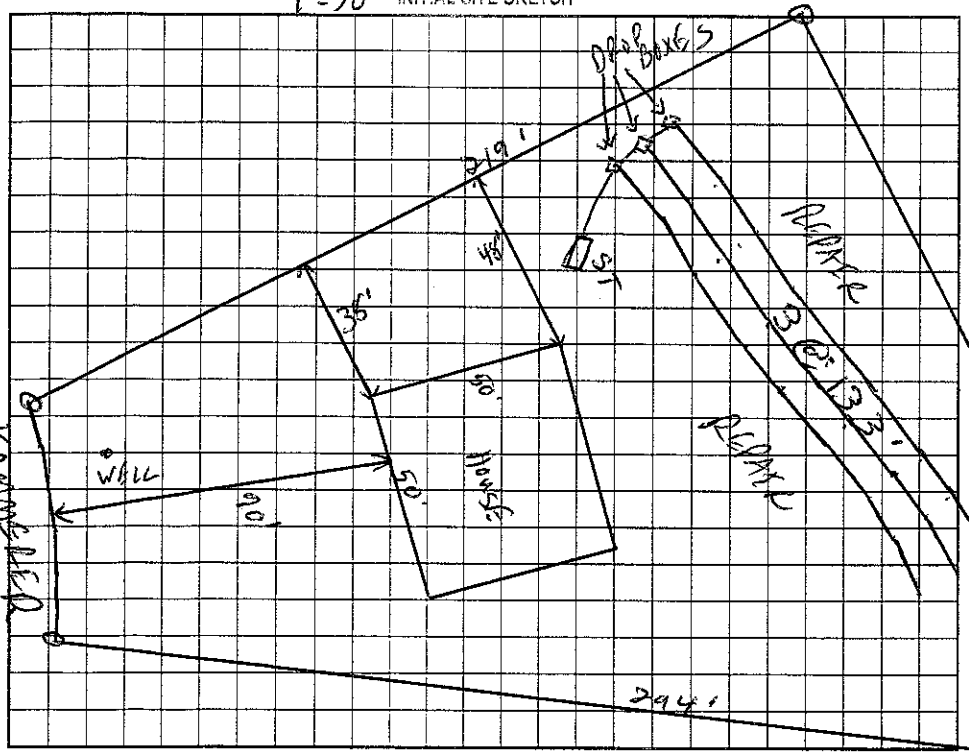

AS BUILT SKETCH

X INSTALLED AS SHOWN

Permit can be suspended or revoked if any false information is supplied toward securing the permit/any unauthorized changes are made to the site/any unauthorized changes are made in the installation of the system. Improvement Permit with plat valid without expiration. Improvement Permit with site plan valid for sixty months. Authorization to Construct is valid for a period equal to that of Improvement Permit – not to exceed sixty months.

Signed: [signature] date 9/23/02 Installed by: Umbarger Backhoe

Improvement Permit by: [signature] RS date 7/23/02 Operation Permit by: Christopher M. Shevill, RS date 3-24-04

Authorization to Construct by: Christopher M. Shevill, RS date 1/23/04 Existing System Inspection by: date

HEALTH DEPT. COPY: WHITE OWNER COPY (FINAL): YELLOW OWNER COPY (INITIAL): PINK