# IREDELL COUNTY HEALTH DEPARTMENT

STATESVILLE 704-878-5305 MOORESVILLE 704-664-5281

## IMPROVEMENT PERMIT / AUTHORIZATION TO CONSTRUCT / OPERATION PERMIT / EXISTING SYSTEM INSPECTION

PERMIT# 107173 PIN# 4823127131 7120 DATE 2/25/04

OWNER OR CONTRACTOR RURAL AFFORDABLE HOUSING PHONE: Business Home

ADDRESS 1321C DIXIE DR. STATESVILLE NC 28677

LOCATION I-15(N) - TR WESTOVER - TR KAMMERER ON RT

SUBDIVISION WESTOVER BLOCK / SECTION LOT 3 LOT AREA .56AC SITE CLASS. PS DESIGN FLOW 360GPD L.T.A.R. .3600/RT2

Septic Tank: 1000 Gallons; STB 160 Date 11-10-03
Pump Tank: Gallons; PT Date
Pump Make: Model Serial No.
Nitrification Field: No Fields 1 Square Feet 900 Linear Feet 300
No Lines 3@100' Trench Width 36" Max Trench Bottom Depth 36" Gravel Depth N/A

☑ New System ☐ Repair System Type: I, II, (III) IV, V, VI
System Description: GRAVITY 25% REDUCTION
Repair System Description: GRAVITY PANEL
Maintenance Agreement Required: ☐ Yes ☑ No


☑ House/Mod. Home No. Bedrooms 3
☐ Mobile Home No. Bathrooms 2
☐ Business No. Employees
☐ Other
☐ Slab ☑ Crawl Space ☐ Basement w/plumbing ☐ Basement wo/plumbing

Water Supply: ☑ Individual ☐ Public ☐ Community


Comments:/Conditions:

Comments:/Conditions: (1) EZ-FLOW (2) INSTALLED ON CONTOUR (3) SLIGHT ALTERATIONS MADE TO SKETCH - TANK MOVED UP HILL

INITIAL SITE SKETCH

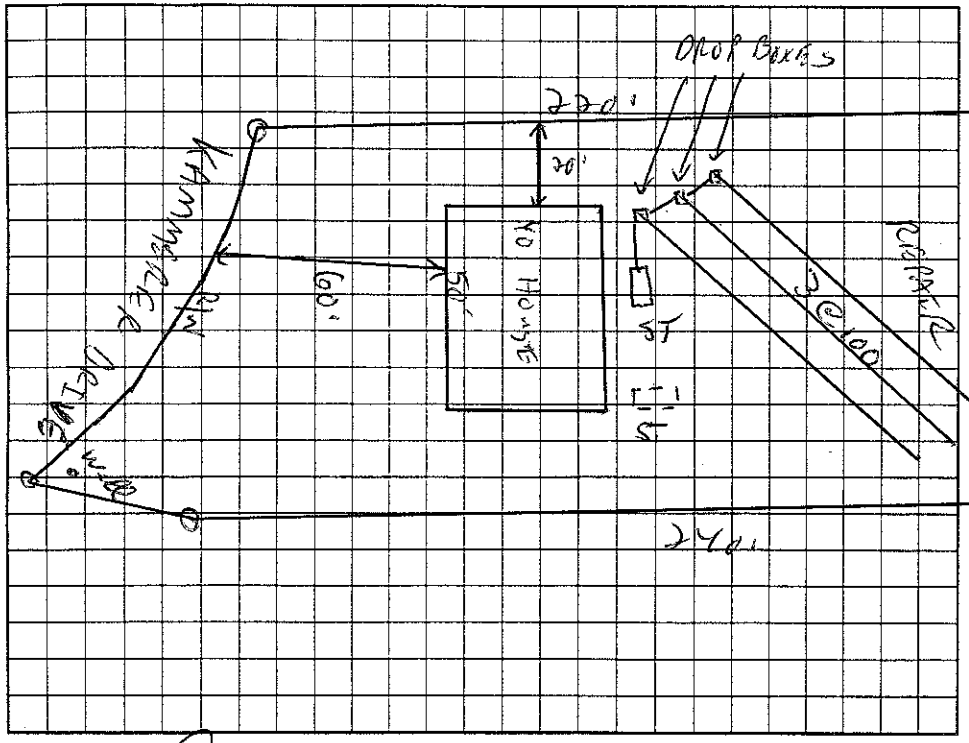


AS BUILT SKETCH

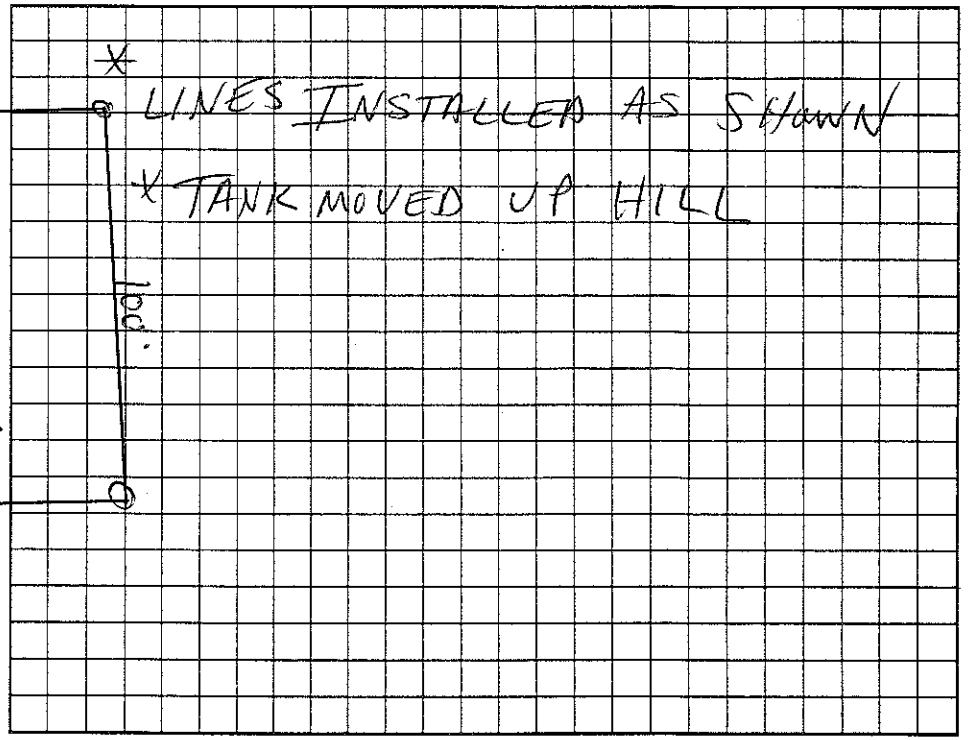


Permit can be suspended or revoked if any false information is supplied toward securing the permit/any unauthorized changes are made to the site/any unauthorized changes are made in the installation of the system. Improvement Permit with plat valid without expiration. Improvement Permit with site plan valid for sixty months. Authorization to Construct is valid for a period equal to that of Improvement Permit – not to exceed sixty months.

Signed: Wayne Burton date 3/1/04 Installed by: Umbarger Backhoe

Improvement Permit by: [signature] date 3/1/04 Operation Permit by: Christopher M. Shirell, RS date 3-15-04

Authorization to Construct by: [signature] date 3/1/04 Existing System Inspection by: date

HEALTH DEPT. COPY: WHITE OWNER COPY (FINAL): YELLOW OWNER COPY (INITIAL): PINK