IREDELL COUNTY HEALTH DEPARTMENT

STATESVILLE 704-878-5305 MOORESVILLE 704-664-5281

IMPROVEMENT PERMIT / AUTHORIZATION TO CONSTRUCT / OPERATION PERMIT / EXISTING SYSTEM INSPECTION

PERMIT# 107171 PIN# 4823127253 DATE 2/25/04

OWNER OR CONTRACTOR RURAL AFFORDABLE HOUSING PHONE: Business 924-5042 Home

ADDRESS 1321 C DIXIE ST STATESVILLE N- 28677

LOCATION 115(N) - TR WESTGLOW - TR 10 KAMMERER DR - ON RT CORNER

SUBDIVISION WESTGLOW BLOCK / SECTION LOT 2 LOT AREA .7AC SITE CLASS. PS DESIGN FLOW 360GPD L.T.A.R. .360GPD

Septic Tank: 1000 Gallons; STB 160 Date 4-13-04

Pump Tank: Gallons; PT Date

Pump Make: Model Serial No.

Nitrification Field: No Fields 1 Square Feet 900 Linear Feet 300

No Lines 3@100' Trench Width 36" Max Trench Bottom Depth 36" Gravel Depth N/A

☑ New System ☐ Repair System Type: I, II, III, IV, V, VI

System Description: GRAVITY 25% REDUCTION

Repair System Description: ~~LPP~~ SAME

Maintenance Agreement Required: ☐ Yes ☑ No

☑ House/Mod. Home No. Bedrooms 3

☐ Mobile Home No. Bathrooms 3

☐ Business No. Employees

☐ Other


☐ Slab ☑ Crawl Space ☐ Basement w/plumbing ☐ Basement wo/plumbing

Water Supply: ☐ Individual ☐ Public ☐ Community


Comments:/Conditions:

Comments:/Conditions: ① Red Poly Filter ② Infiltrator Chambers

INITIAL SITE SKETCH 1" = 50'

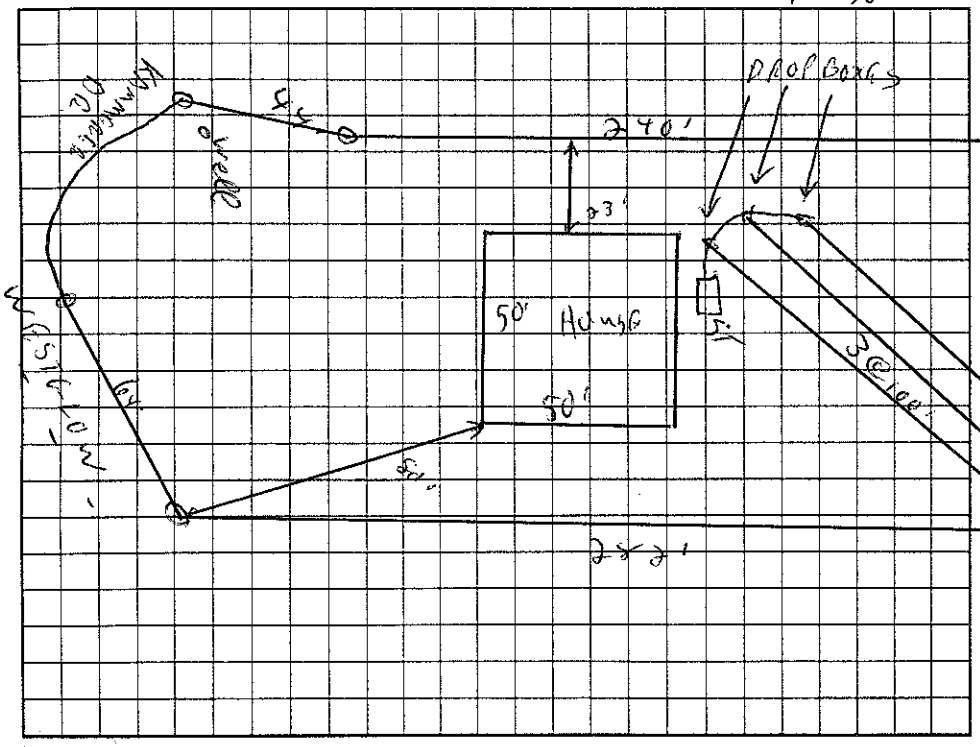

AS BUILT SKETCH

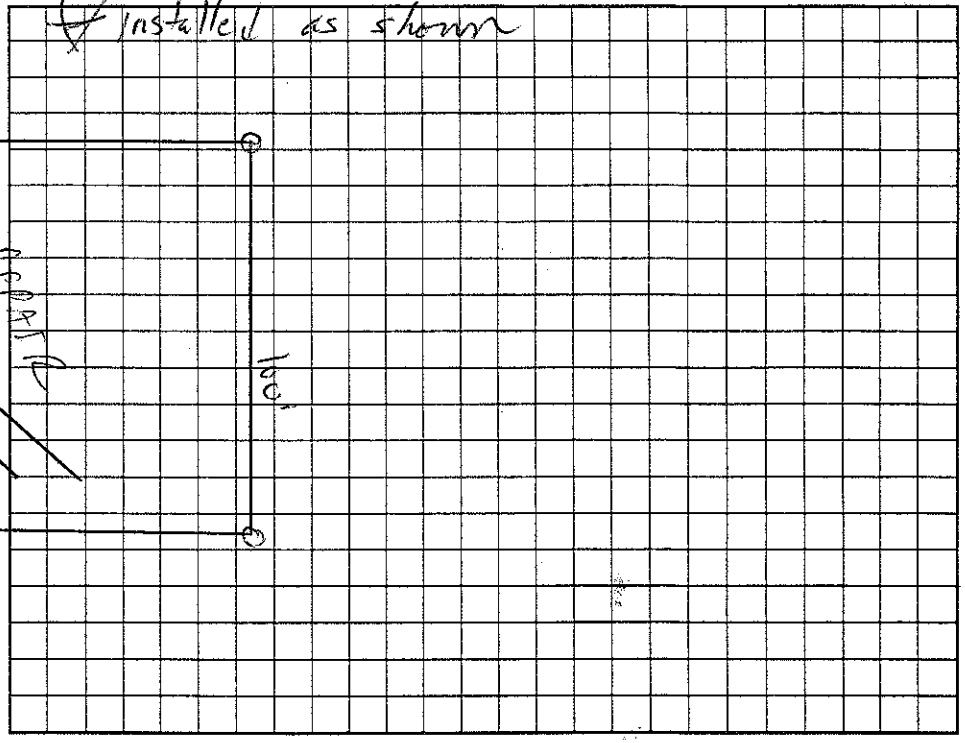

Permit can be suspended or revoked if any false information is supplied toward securing the permit/any unauthorized changes are made to the site/any unauthorized changes are made in the installation of the system. Improvement Permit with plat valid without expiration. Improvement Permit with site plan valid for sixty months. Authorization to Construct is valid for a period equal to that of Improvement Permit – not to exceed sixty months.

Signed: C Wayne Burton date 3/1/04 Installed by: UMBARGER BACKHOE

Improvement Permit by: C. Wayne Burton REHS date 3/1/04 Operation Permit by: Chris Hall date 11-29-04

Authorization to Construct by: C. Wayne Burton REHS date 3/1/04 Existing System Inspection by: date

HEALTH DEPT. COPY: WHITE OWNER COPY (FINAL): YELLOW OWNER COPY (INITIAL): PINK