IREDELL COUNTY HEALTH DEPARTMENT

STATESVILLE 704-878-5305 MOORESVILLE 704-664-5281

IMPROVEMENT PERMIT / AUTHORIZATION TO CONSTRUCT / OPERATION PERMIT / EXISTING SYSTEM INSPECTION

PERMIT# 10774 PIN# 4823127020 7935 DATE 2/25/04

OWNER OR CONTRACTOR RURAL AFFORDABLE HOUSING PHONE: Business 927-8442 Home

ADDRESS 1321 C. DIXIE DR STATESVILLE NC 28677

LOCATION 115 (W) - TR WESTGLOW - TR KAMMERER DR - ON RT

SUBDIVISION WESTGLOW BLOCK / SECTION LOT 4 LOT AREA .9 AC SITE CLASS. PS DESIGN FLOW 360GPD L.T.A.R. .36 PD/ACRE

Septic Tank: 1000 Gallons; STB 160 Date 5-7-04
Pump Tank: 1000 Gallons; PT 319 Date 6-4-04
Pump Make: MYERS Model ME 503-11 Serial No.
Nitrification Field: No Fields 1 Square Feet 900 Linear Feet 300
No Lines 4 @ 75' Trench Width 36" Max Trench Bottom Depth 36" Gravel Depth N/A

☑ New System ☐ Repair System Type: I, II, (III) IV, V, VI
System Description: PUMP 25% REDUCTION
Repair System Description: PUMP PANEL
Maintenance Agreement Required: ☐ Yes ☑ No


☑ House/Mod. Home No. Bedrooms 3
☐ Mobile Home No. Bathrooms 3
☐ Business No. Employees
☐ Other
☐ Slab ☑ Crawl Space ☐ Basement w/plumbing ☐ Basement wo/plumbing

Water Supply: ☑ Individual ☐ Public ☐ Community

Comments:/Conditions:

INITIAL SITE SKETCH

1" = 50'

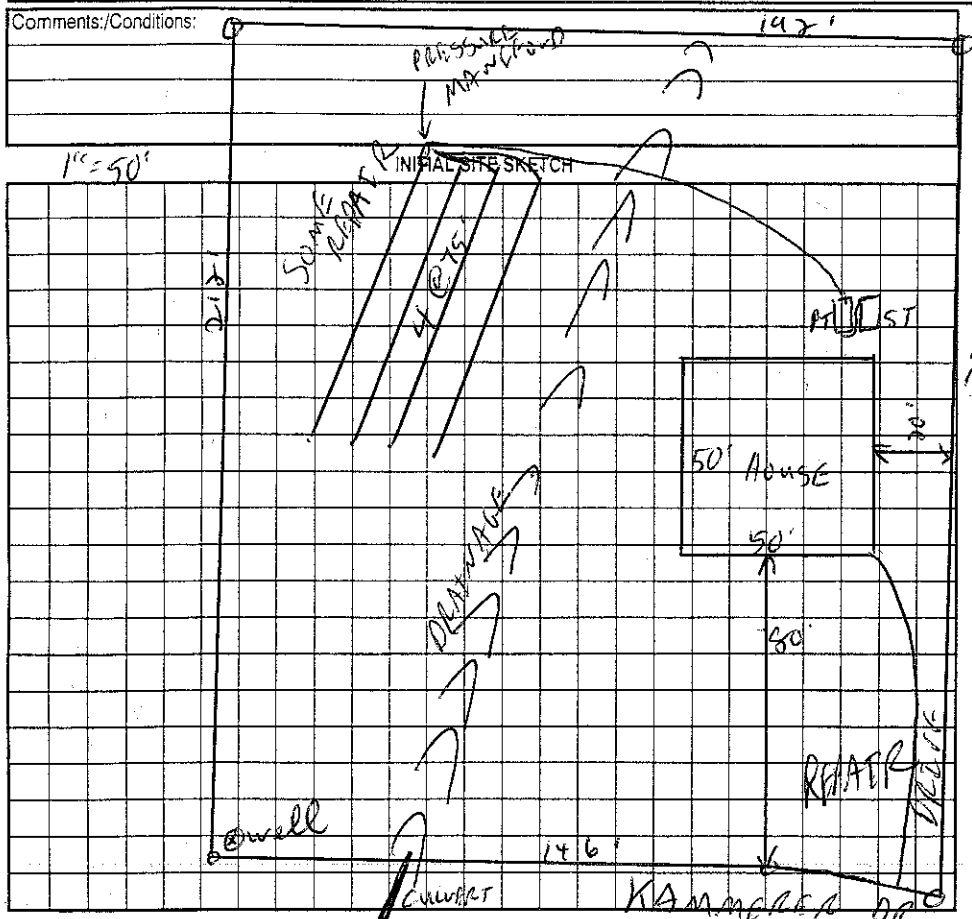

Comments:/Conditions: ~~(1) 1,250 gal Septic tanks~~ (1) (2) Red Polylok filter (2) 18" riser (3) Biodiffuser chambers

AS BUILT SKETCH

System installed as shown.

☑ Ops Check
☑ Remv 4x
☑ High Water Alarm

Permit can be suspended or revoked if any false information is supplied toward securing the permit/any unauthorized changes are made to the site/any unauthorized changes are made in the installation of the system. Improvement Permit with plat valid without expiration. Improvement Permit with site plan valid for sixty months. Authorization to Construct is valid for a period equal to that of Improvement Permit – not to exceed sixty months.

Signed: (C) Wayne Burton date 3/1/04 Installed by: Umbarger Backhoe

Improvement Permit by: [signature] RS date 2/25/04 Operation Permit by: [signature] date 7-22-04

Authorization to Construct by: [signature] RS date 3/1/04 Existing System Inspection by: date

HEALTH DEPT. COPY: WHITE OWNER COPY (FINAL): YELLOW OWNER COPY (INITIAL): PINK