THIS PERMIT VOIDS PREVIOUS ISSUED 7-6-2000

IREDELL COUNTY HEALTH DEPARTMENT

STATESVILLE 704-878-5305 MOORESVILLE 704-664-5281

IMPROVEMENT PERMIT / AUTHORIZATION TO CONSTRUCT / OPERATION PERMIT / EXISTING SYSTEM INSPECTION

PERMIT# 090328 PIN# 4823 28 1967 (PART) DATE 10-15-2001

OWNER OR CONTRACTOR BARRY SHEPHERD PHONE: Business (704) 924-2019 Home (704) 872-2584

ADDRESS 620 GREENWAY DR, STATESVILLE, NC 28677

LOCATION NC 115 N, TR FLETCHER ROAD, HOUSE ON LEFT ~ 0.5 MILE.

SUBDIVISION _____ BLOCK / SECTION _____ LOT _____ LOT AREA _____ SITE CLASS PS DESIGN FLOW 360 L.T.A.R. 0.30 GPD/FT²

Septic Tank: 1000 Gallons: STB 854 Date 8-27-01
Pump Tank: _____ Gallons: PT _____ Date _____
Pump Make: _____ Model _____ Serial No. _____
Nitrification Field: No Fields 1 Square Feet 1200 Linear Feet 400
No Lines FOUR Trench Width 36" Max Trench Bottom Depth 36" Gravel Depth 12"

☑ New System ☐ Repair System Type: I II III IV V VI
System Description: CONVENTIONAL GRAVITY
Repair System Description: CONV. GRAVITY
Maintenance Agreement Required: ☐ Yes ☑ No
☐ Slab ☐ Crawl Space ☑ Basement w/plumbing ☐ Basement wo/plumbing


☐ House/Mod. Home No. Bedrooms 3
☐ Mobile Home No. Bathrooms 3.5
☐ Business No. Employees ____
☐ Other _____

Water Supply: ☑ Individual ☐ Public ☐ Community
WELL

Comments/Conditions: USE ONE FLOW DIVIDER TEE TO ACHIEVE EQUAL DISTRIBUTION INTO TWO DROP BOXES FEEDING TWO LINES EACH. ② INSTALL LINES ON CONTOUR AS FLAGGED ON SITE.

Comments/Conditions: SEPTIC TANK WITH RISERS INSTALLED USING "ZABEL" FILTER

INITIAL SITE SKETCH

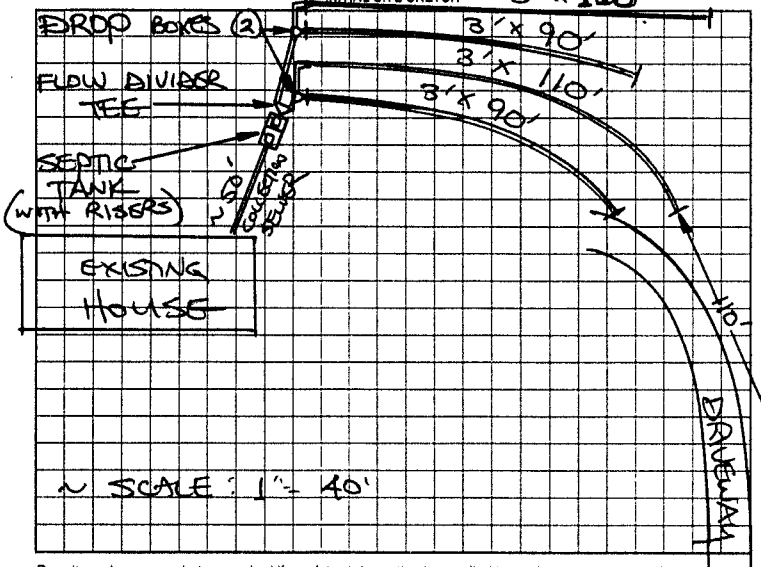

AS BUILT SKETCH



Permit can be suspended or revoked if any false information is supplied toward securing the permit/any unauthorized changes are made to the site/any unauthorized changes are made in the installation of the system. Improvement Permit with plat valid without expiration. Improvement Permit with site plan valid for sixty months. Authorization to Construct is valid for a period equal to that of Improvement Permit – not to exceed sixty months.

Signed: Tommy Shepherd date 10-17-01
Improvement Permit by: STEVE HEDRICK date 10-15-01
Authorization to Construct by: STEVE HEDRICK date 10-15-01

Installed by: CHURCH'S BACKHOE
Operation Permit by: STEVE HEDRICK date 10.25.01
Existing System Inspection by: _____ date _____

FLETCHER ROAD (SR 1803)

HEALTH DEPT COPY (WHITE) OWNER COPY (FINAL) YELLOW OWNER COPY (INITIAL) PINK