IREDELL COUNTY HEALTH DEPARTMENT

STATESVILLE 704-878-5305 MOORESVILLE 704-664-5281

IMPROVEMENT PERMIT / AUTHORIZATION TO CONSTRUCT / OPERATION PERMIT / EXISTING SYSTEM INSPECTION

PERMIT# 107201 PIN# 4823 ~~85285~~ 21-0751 DATE 7/26/02

OWNER OR CONTRACTOR RURAL AFFORDABLE HOUSING PHONE: Business 924-8942 Home

ADDRESS 1321 C DIXIE DR. STATESVILLE NC 28677

LOCATION 115(N) - TR WESTGLOW - TR KAMMERER - ON LT

SUBDIVISION WEST GLOW BLOCK / SECTION LOT 15 LOT AREA .65AC SITE CLASS. PS DESIGN FLOW 360GPD L.T.A.R. .3600/FT²

Septic Tank: 1000 Gallons; STB 160 Date 12-2-03
Pump Tank: Gallons; PT Date
Pump Make: Model Serial No.
Nitrification Field: No Fields 1 Square Feet 900 Linear Feet 300
No Lines 4 Trench Width 36" Max Trench Bottom Depth 36" Gravel Depth

☑ New System ☐ Repair System Type: I, II, (III), IV, V, VI
System Description: GRAVITY INNOVATIVE
Repair System Description: LP PANEL
Maintenance Agreement Required: ☐ Yes ☑ No

☑ House/Mod. Home No. Bedrooms 3
☐ Mobile Home No. Bathrooms 3
☐ Business No. Employees
☐ Other


☐ Slab ☑ Crawl Space ☐ Basement w/plumbing ☐ Basement wo/plumbing

Water Supply: ☑ Individual ☐ Public ☐ Community


Comments:/Conditions:

Comments:/Conditions: ① ZABEL FILTER ② E2-FLOW ③ SLIGHT ALTERATIONS MADE TO SKETCH

INITIAL SITE SKETCH 1"=50'

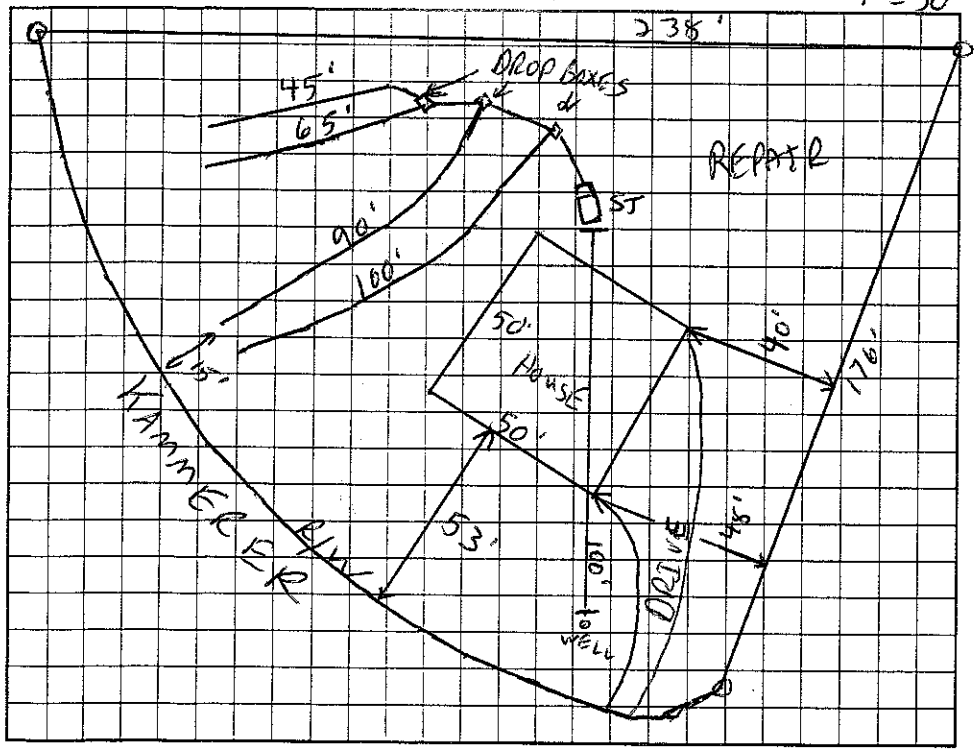

AS BUILT SKETCH

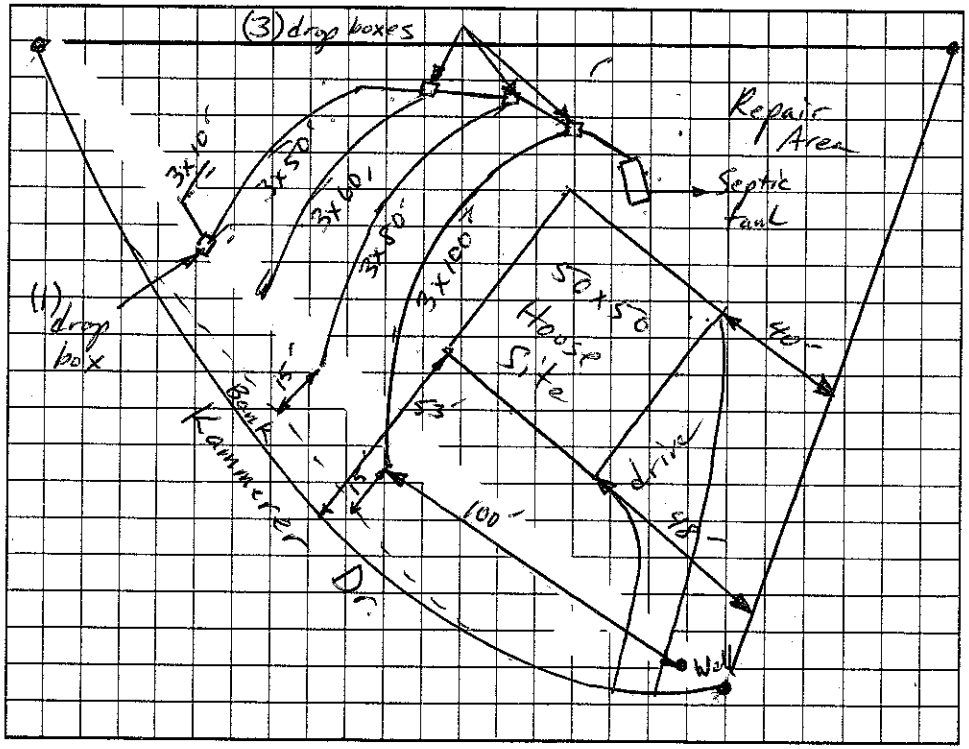

Permit can be suspended or revoked if any false information is supplied toward securing the permit/any unauthorized changes are made to the site/any unauthorized changes are made in the installation of the system. Improvement Permit with plat valid without expiration. Improvement Permit with site plan valid for sixty months. Authorization to Construct is valid for a period equal to that of Improvement Permit – not to exceed sixty months.

Signed: date 7/26/02 Installed by: Umbrauger Backhoe

Improvement Permit by: KS date 7/26/02 Operation Permit by: Christopher M. Sherrill, RS date 3-24-04

Authorization to Construct by: Christopher M. Sherrill, RS date 1/23/04 Existing System Inspection by: date

HEALTH DEPT. COPY: WHITE OWNER COPY (FINAL): YELLOW OWNER COPY (INITIAL): PINK