IREDELL COUNTY HEALTH DEPARTMENT

STATESVILLE 704-878-5305 MOORESVILLE 704-664-5281

IMPROVEMENT PERMIT / AUTHORIZATION TO CONSTRUCT / OPERATION PERMIT / EXISTING SYSTEM INSPECTION

PERMIT# 119211 PIN# ~~4823-12-9054~~ 4823-21-0931 DATE 3/5/04

OWNER OR CONTRACTOR RURAL AFFORDABLE HOUSING INC PHONE: Business 902-5557 Home

ADDRESS 1321C DIXIE ST STATESVILLE NC 28677

LOCATION 115(N) - TR WESTGLOW - TR KAMMERER - ON LT CORNER

SUBDIVISION WESTGLOW BLOCK / SECTION LOT 18 LOT AREA .654C SITE CLASS PS DESIGN FLOW 360GPD L.T.A.R. .36PD/FT2

Septic Tank: 1000 Gallons; STB 160 Date 7-14-04

Pump Tank: 1000 Gallons; PT 319 Date 6-27-04

Pump Make: MYERS Model ME 3H-11 Serial No. 1003

Nitrification Field: No Fields 1 Square Feet 900 Linear Feet 300

No Lines 3@100' Trench Width 36" Max Trench Bottom Depth 36" Gravel Depth N/A

☑ New System ☐ Repair System Type: I, II, (III), IV, V, VI

System Description: PUMP 25% REDUCTION

Repair System Description: LP PANEL

Maintenance Agreement Required: ☐ Yes ☑ No

☑ House/Mod. Home No. Bedrooms 3

☐ Mobile Home No. Bathrooms 3

☐ Business No. Employees

☐ Other


☐ Slab ☐ Crawl Space ☐ Basement w/plumbing ☐ Basement wo/plumbing

Water Supply: ☑ Individual ☐ Public ☐ Community

Comments:/Conditions:

Comments:/Conditions: (1) E-Z FLOW (2) TANKS LOCATED 73' FROM WELL (3) RED POLYLOK (4) 18" RISER

INITIAL SITE SKETCH 1" = 50'

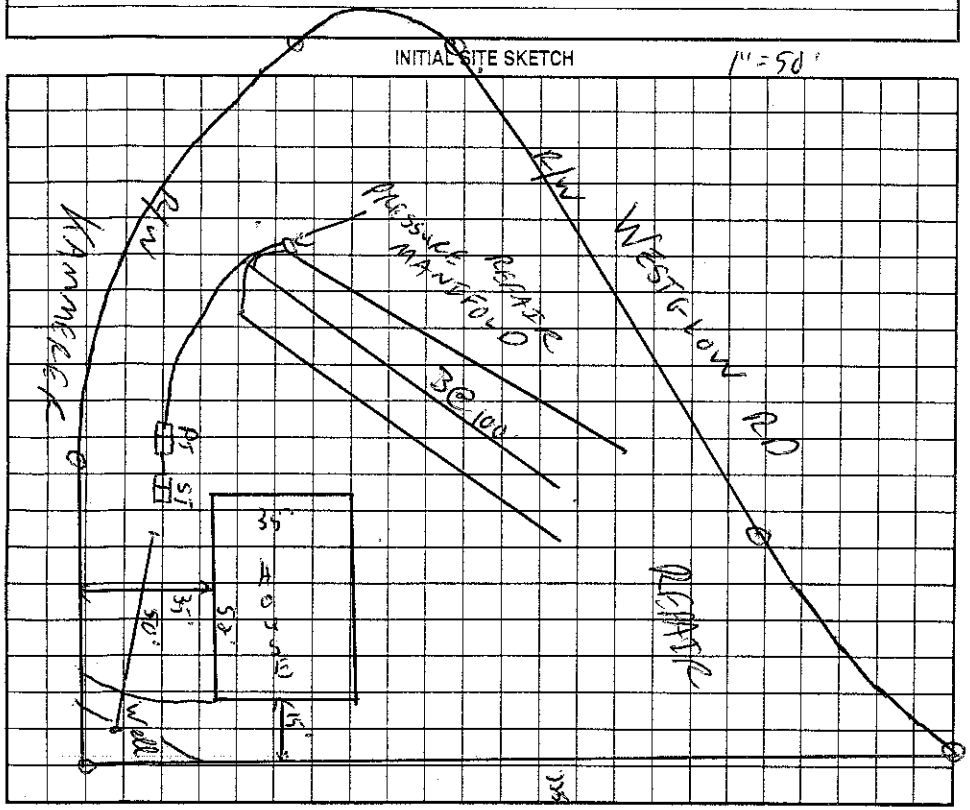

AS BUILT SKETCH

X SYSTEM INSTALLED ACCORDING TO SKETCH

☑ OPS CHECK

☑ NEMA 4X

☑ HIGH WATER ALARM

☑ SEPARATE WIRING ALARM/PUMP

Permit can be suspended or revoked if any false information is supplied toward securing the permit/any unauthorized changes are made to the site/any unauthorized changes are made in the installation of the system. Improvement Permit with plat valid without expiration. Improvement Permit with site plan valid for sixty months. Authorization to Construct is valid for a period equal to that of Improvement Permit – not to exceed sixty months.

Signed: Wayne Burton date 4/6/04

Improvement Permit by: C. Hoe RS date 3/5/04

Authorization to Construct by: C. Hoe RS date 3/5/04

Installed by: UMBARGER BACKHOE

Operation Permit by: Christopher M. Shull date 10-1-04

Existing System Inspection by: date

HEALTH DEPT. COPY: WHITE OWNER COPY (FINAL): YELLOW OWNER COPY (INITIAL): PINK