IREDELL COUNTY HEALTH DEPARTMENT

STATESVILLE 704-878-5305 MOORESVILLE 704-664-5281

IMPROVEMENT PERMIT / AUTHORIZATION TO CONSTRUCT / OPERATION PERMIT / EXISTING SYSTEM INSPECTION

PERMIT# 118325 PIN# 4823 210931 DATE 3/5/04

OWNER OR CONTRACTOR RURAL AFFORDABLE HOUSING PHONE: Business 902-5557 Home

ADDRESS 1321 C. DIXIE ST STATESVILLE NC 28677

LOCATION 115 (N) - TR - WESTGLOW - TR KAMMERER - ON LT

SUBDIVISION WESTGLOW BLOCK / SECTION LOT 17 LOT AREA .62 AC SITE CLASS. AS DESIGN FLOW 360GPD L.T.A.R. .36 AC/KFR

Septic Tank: 1000 Gallons; STB 168 Date 8-2-04
Pump Tank: 1000 Gallons; PT 399 Date 8-9-04
Pump Make: Model Serial No.
Nitrification Field: No Fields 1 Square Feet 900 Linear Feet 300
No Lines 9@75 Trench Width 36" Max Trench Bottom Depth 36" Gravel Depth N/A

☒ New System ☐ Repair System Type: I, II, III, IV, V, VI
System Description: PUMP 25% REDUCTION
Repair System Description: LP PANEL
Maintenance Agreement Required: ☐ Yes ☒ No


☒ House/Mod. Home No. Bedrooms 3
☐ Mobile Home No. Bathrooms 3
☐ Business No. Employees
☐ Other
☐ Slab ☒ Crawl Space ☐ Basement w/plumbing ☐ Basement wo/plumbing

Water Supply: ☒ Individual ☐ Public ☐ Community


Comments:/Conditions:

Comments:/Conditions: 8/11/04
POLYLOK FILTER SYSTEM
V'D LINES.

INITIAL SITE SKETCH 1" = 50'

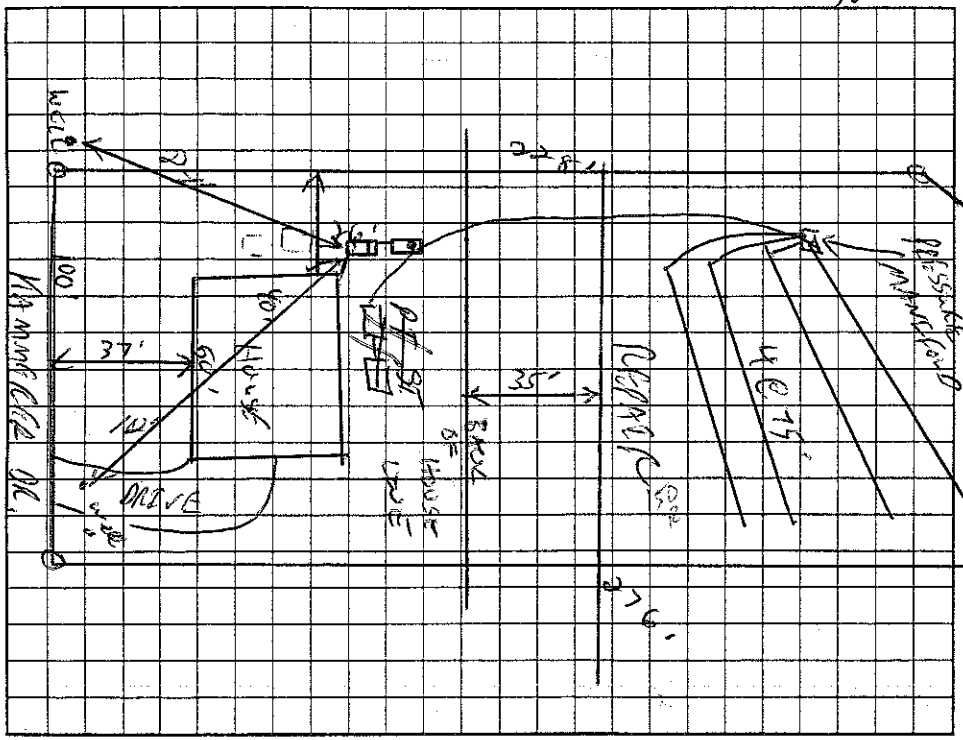

AS BUILT SKETCH

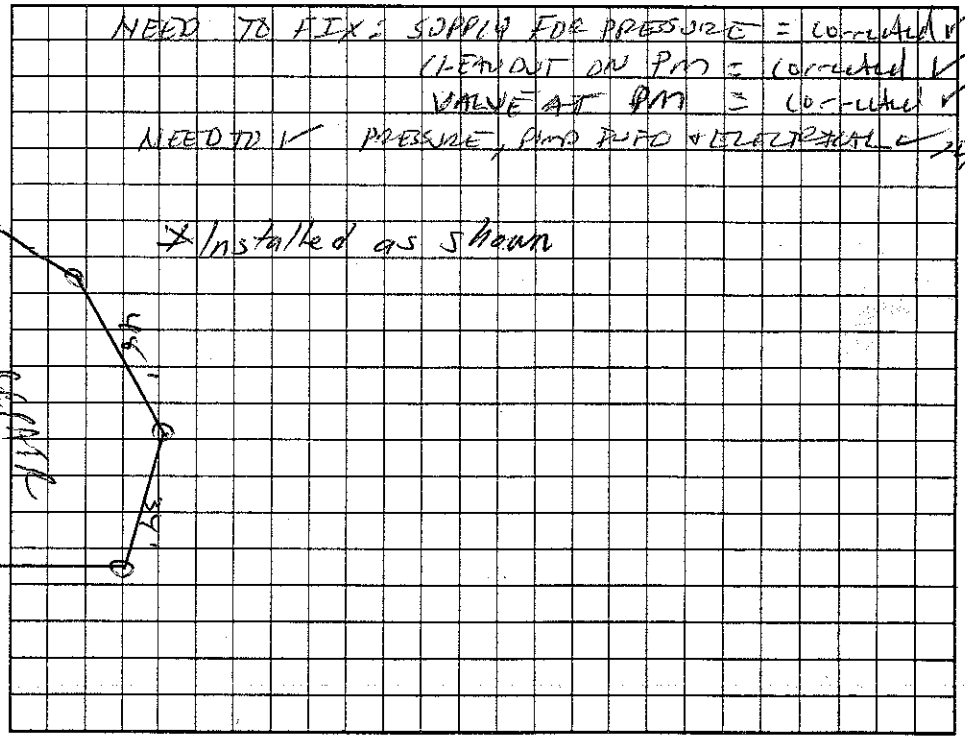

Permit can be suspended or revoked if any false information is supplied toward securing the permit/any unauthorized changes are made to the site/any unauthorized changes are made in the installation of the system. Improvement Permit with plat valid without expiration. Improvement Permit with site plan valid for sixty months. Authorization to Construct is valid for a period equal to that of Improvement Permit – not to exceed sixty months.

Signed: Wayne Burton date 4/6/04 Installed by: DAVID VAN BARGEN

Improvement Permit by: RS date 3/5/04 Operation Permit by: RS date 10-29-04

Authorization to Construct by: RS date 3/5/04 Existing System Inspection by: date

HEALTH DEPT. COPY: WHITE OWNER COPY (FINAL): YELLOW OWNER COPY (INITIAL): PINK