IREDELL COUNTY HEALTH DEPARTMENT

STATESVILLE 704-878-5305 MOORESVILLE 704-664-5281

IMPROVEMENT PERMIT / AUTHORIZATION TO CONSTRUCT / OPERATION PERMIT / EXISTING SYSTEM INSPECTION

PERMIT# 107187 PIN# ~~4883-21-1426~~ 4823-21-1315 DATE 2/25/04

OWNER OR CONTRACTOR RURAL AFFORDABLE HOUSING PHONE: Business 924-5042 Home

ADDRESS 1321 C DIXIE ST STATESVILLE NC 28677

LOCATION I-77(N) - TR WESTFLOW - TR 140 KAMMERER DR - ON RT NEAR END

SUBDIVISION WESTFLOW BLOCK / SECTION LOT 11 LOT AREA 1.54Ac SITE CLASS PS DESIGN FLOW 360GPD L.T.A.R. 1.36PO/ET2

Septic Tank: 1000 Gallons; STB 160 Date 12-4-03

Pump Tank: Gallons; PT Date

Pump Make: Model Serial No.

Nitrification Field: No Fields 1 Square Feet 900 Linear Feet 300

No Lines 3@100' Trench Width 36" Max Trench Bottom Depth 36" Gravel Depth N/A

☒ New System ☐ Repair System Type: I, II, III, IV, V, VI

System Description: GRAVITY 25% REDUCTION

Repair System Description: LP PANEL

Maintenance Agreement Required: ☐ Yes ☒ No

☐ House/Mod. Home No. Bedrooms 3

☑ Mobile Home No. Bathrooms 3

☐ Business No. Employees

☐ Other


☐ Slab ☑ Crawl Space ☐ Basement w/plumbing ☐ Basement wo/plumbing

Water Supply: ☒ Individual ☐ Public ☐ Community


Comments:/Conditions:

Comments:/Conditions: (1) RED PLYLOK @ 6"P-TRAP (3) QUICK4 CHAMBERS STD-W H-10

INITIAL SITE SKETCH 1"=50'

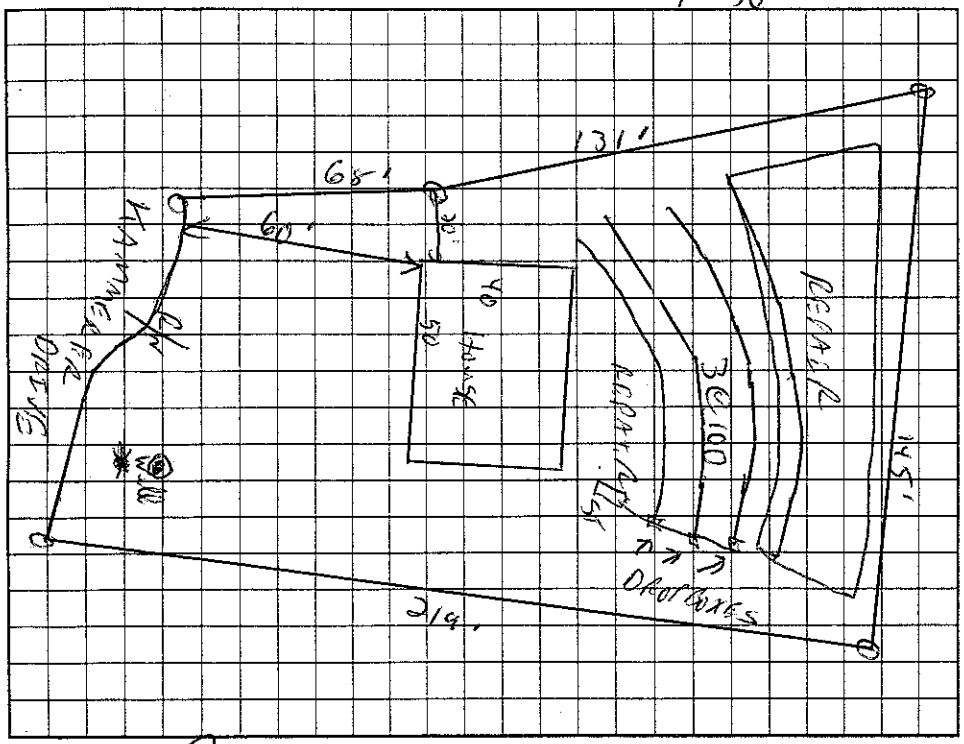

AS BUILT SKETCH

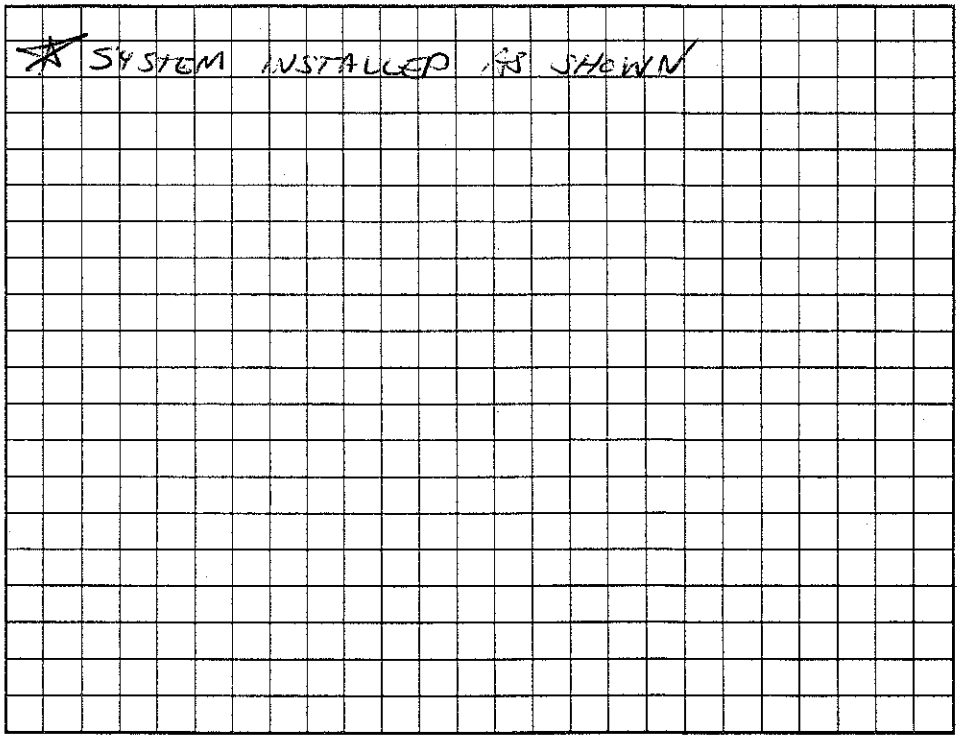

Permit can be suspended or revoked if any false information is supplied toward securing the permit/any unauthorized changes are made to the site/any unauthorized changes are made in the installation of the system. Improvement Permit with plat valid without expiration. Improvement Permit with ~~site plan~~ valid for sixty months. Authorization to Construct is valid for a period equal to that of Improvement Permit – not to exceed sixty months.

Signed: Wayne Burton date 3/1/04 Installed by: UMBARGER BACKHOE

Improvement Permit by: date 3/1/04 Operation Permit by: date 12/30/04

Authorization to Construct by: date 3/1/04 Existing System Inspection by: date

HEALTH DEPT. COPY: WHITE OWNER COPY (FINAL): YELLOW OWNER COPY (INITIAL): PINK