* PERMIT VOIDS EXISTING PERMIT DATED 2-25-04

IREDELL COUNTY HEALTH DEPARTMENT

STATESVILLE 704-878-5305 MOORESVILLE 704-664-5281

IMPROVEMENT PERMIT / AUTHORIZATION TO CONSTRUCT / OPERATION PERMIT / EXISTING SYSTEM INSPECTION

PERMIT# 119212 PIN# 4823-21-2334 DATE 3-17-05

OWNER OR CONTRACTOR RURAL AFFORDABLE HOUSING PHONE: Business (704) 924-8942 Home

ADDRESS 1321-C DIXIE ST. STATESVILLE NC 28677

LOCATION I-77N TO EXIT 65 TL HWY 901 TL HWY 115 TL WESTGLOW SUBDIVISION OR RIGHT

SUBDIVISION WESTGLOW BLOCK / SECTION LOT 12 LOT AREA 0.71 SITE CLASS. PS DESIGN FLOW 360 L.T.A.R. 0.25 gpd/ft²

Septic Tank: 1000 Gallons; STB 160 Date 2-2-05
Pump Tank: Gallons; PT Date
Pump Make: Model Serial No.
Nitrification Field: No Fields 1 Square Feet 1440 Linear Feet 250
No Lines 5 Trench Width 24" Max Trench Bottom Depth 30" Gravel Depth 24" SAND

☑ New System ☐ Repair System Type: I, II, (III) IV, V, VI
System Description: GRAVITY PANEL 50% REDUCTION
Repair System Description: LP PANEL 50% REDUCTION
Maintenance Agreement Required: ☐ Yes ☑ No


☑ House/Mod. Home No. Bedrooms 3
☑ Mobile Home No. Bathrooms
☑ Business No. Employees
☐ Other
☐ Slab ☐ Crawl Space ☐ Basement w/plumbing ☑ Basement wo/plumbing

Water Supply: ☑ Individual ☐ Public ☐ Community

Comments/Conditions: ① INSTALL LINES NO DEEPER THAN 30" ON CONTOUR ② MAINTAIN ALL SETBACKS ③ SUPPLY LINE MUST BE SLEEVED WHEN CROSSING DRAINAGE PATTERN ④ INSTALL 55 TOTAL PANELS ⑤ RAKE & LIME TRENCHES ⑥ USE APPROVED SEALANT BETWEEN PANELS

Comments/Conditions: ⑦ SYSTEM INSTALLED USING 'ZABEL' FILTER ⑧ 'SPACE INVADER' SEALANT

INITIAL SITE SKETCH

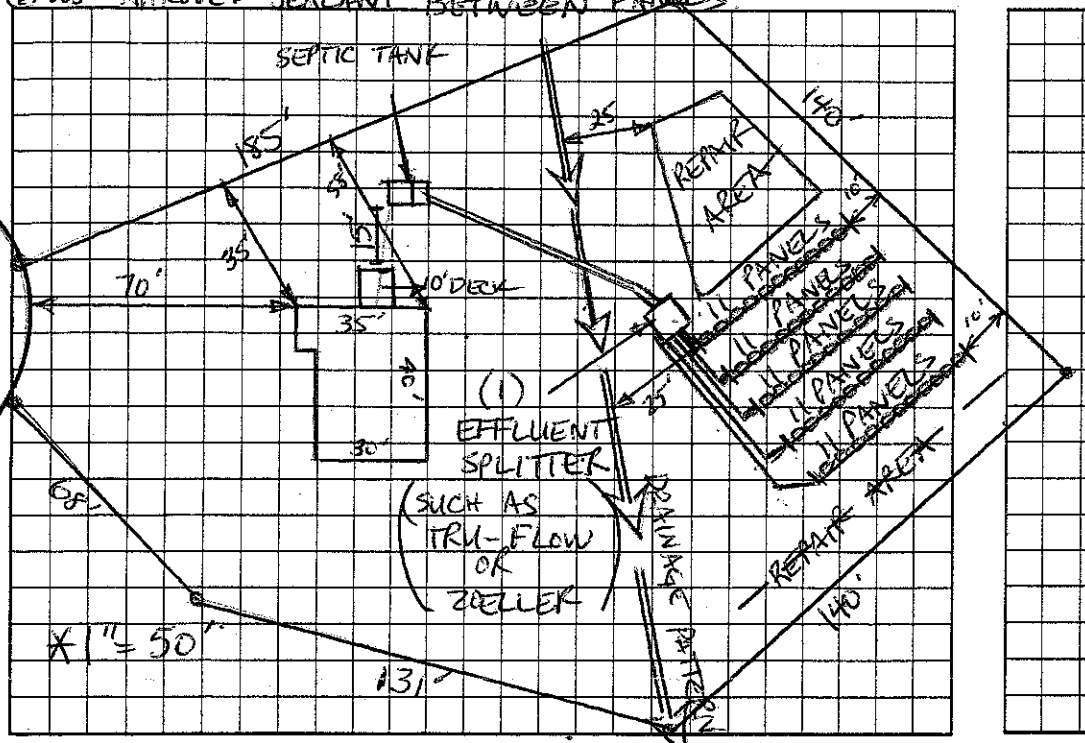

AS BUILT SKETCH

SYSTEM INSTALLED ACCORDING TO SKETCH

Permit can be suspended or revoked if any false information is supplied toward securing the permit/any unauthorized changes are made to the site/any unauthorized changes are made in the installation of the system. Improvement Permit with plat valid without expiration. Improvement Permit with site plan valid for sixty months. Authorization to Construct is valid for a period equal to that of Improvement Permit – not to exceed sixty months.

Signed: date Installed by: UMBARGER BACKHOE

Improvement Permit by: Christopher M. Sherrill RS, LSS date 3-17-05 Operation Permit by: Christopher M. Sherrill RS, LSS date 4-12-05

Authorization to Construct by: Christopher M. Sherrill RS, LSS date 4-12-05 Existing System Inspection by: date

HEALTH DEPT. COPY: WHITE OWNER COPY (FINAL): YELLOW OWNER COPY (INITIAL): PINK