IREDELL COUNTY HEALTH DEPARTMENT

STATESVILLE 704-878-5305 (C1) MOORESVILLE 704-664-5281

IMPROVEMENT PERMIT / AUTHORIZATION TO CONSTRUCT / OPERATION PERMIT / EXISTING SYSTEM INSPECTION

PERMIT# 107196 PIN# ~~4823-11-9528.13~~ 4823-21-2621 DATE 7/25/02

OWNER OR CONTRACTOR RURAL AFFORDABLE HOUSING PHONE: Business 924-8942 Home

ADDRESS 1321 C DIXIE DRIVE STATESVILLE NC 28677

LOCATION 115(N) - TR WESTGLOW - TR KAMMERER ATEND

SUBDIVISION WESTGLOW BLOCK / SECTION LOT 13 LOT AREA .63AC SITE CLASS. PS DESIGN FLOW 360GPD L.T.A.R. .36-PD/FT²

Septic Tank: 1000 Gallons; STB 160 Date 9-18-03
Pump Tank: Gallons; PT Date
Pump Make: Model Serial No.
Nitrification Field: No Fields 1 Square Feet 900 Linear Feet 300
No Lines 6@50' Trench Width 36" Max Trench Bottom Depth 36" Gravel Depth N/A


☑ New System ☐ Repair System Type: I, II, (III), IV, V, VI
System Description: GRAVITY INNOVATIVE
Repair System Description: LP PANEL C
Maintenance Agreement Required: ☐ Yes ☑ No

☑ House/Mod. Home No. Bedrooms 3
☐ Mobile Home No. Bathrooms 3
☐ Business No. Employees
☐ Other
☐ Slab ☑ Crawl Space ☐ Basement w/plumbing ☐ Basement wo/plumbing

Water Supply: ☑ Individual ☐ Public ☐ Community


Comments:/Conditions:

INITIAL SITE SKETCH 1"=50'

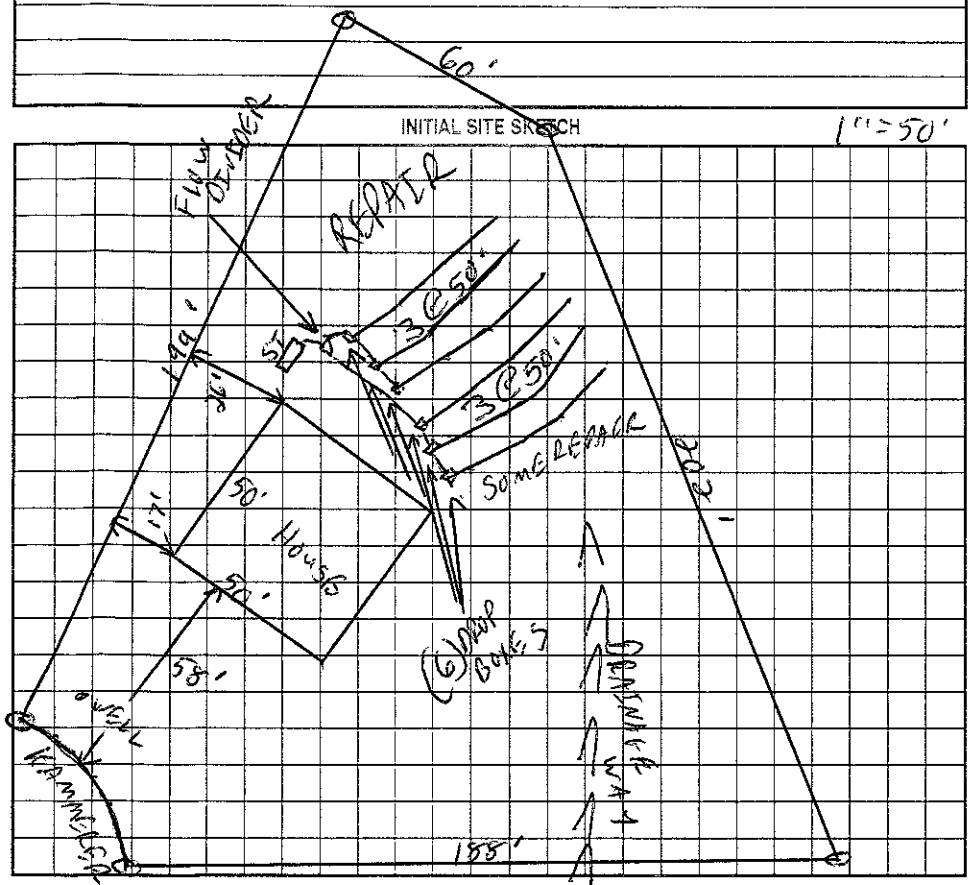

Comments:/Conditions: SEPTIC TANK WITH MARKER INSTALLED USING "ZABEL" FILTER SYSTEM INSTALLED USING 48 "INFILTRATOR" CHAMBERS

AS BUILT SKETCH

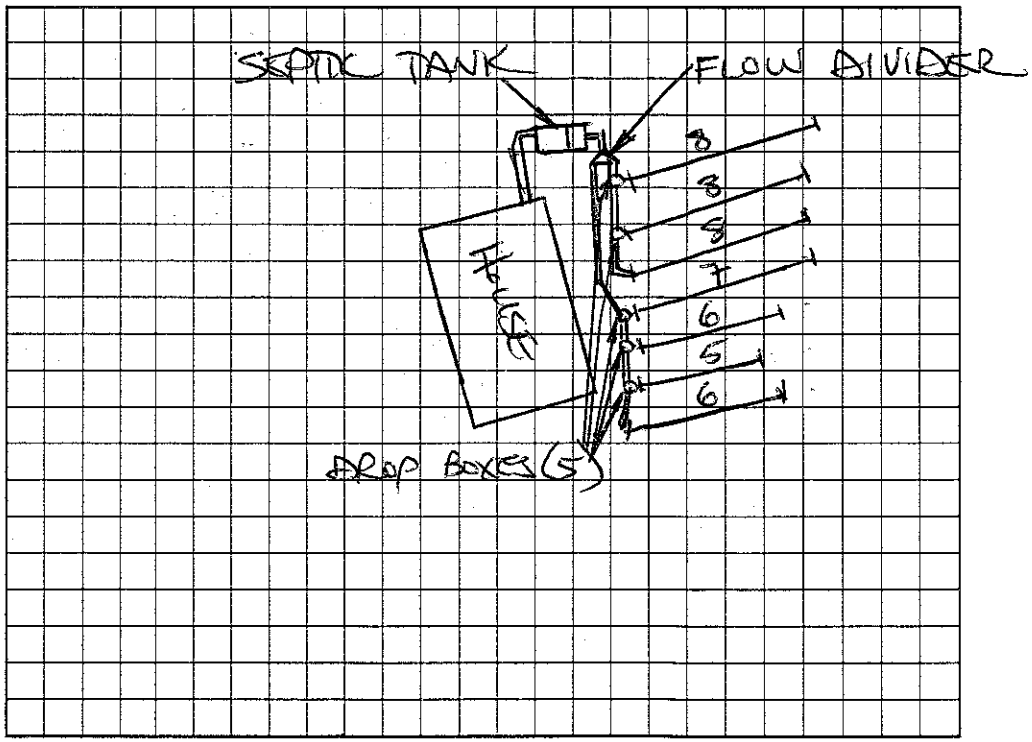

Permit can be suspended or revoked if any false information is supplied toward securing the permit/any unauthorized changes are made to the site/any unauthorized changes are made in the installation of the system. Improvement Permit with plat valid without expiration. Improvement Permit with site plan valid for sixty months. Authorization to Construct is valid for a period equal to that of Improvement Permit – not to exceed sixty months.

Signed: date 8/1/03 Installed by: DAVID UMBARGER

Improvement Permit by: C. S. RS date 7/25/02 Operation Permit by: STEVE HEDRICK date 11-24-03

Authorization to Construct by: STEVE HEDRICK date 8-6-03 Existing System Inspection by: date

HEALTH DEPT. COPY: WHITE OWNER COPY (FINAL): YELLOW OWNER COPY (INITIAL): PINK