IREDELL COUNTY HEALTH DEPARTMENT

STATESVILLE 704-878-5305 MOORESVILLE 704-664-5281

IMPROVEMENT PERMIT / AUTHORIZATION TO CONSTRUCT / OPERATION PERMIT / EXISTING SYSTEM INSPECTION

PERMIT# 089777 PIN# 4823 22 3212 DATE 6-13-2000

OWNER OR CONTRACTOR ROGER SNEED PHONE: Business Home 592-2701

ADDRESS 506 WESTGLOW ROAD STATESVILLE NC 28625

LOCATION NC 115 NORTH, TR WESTGLOW ROAD 0.2 MILE ON LEFT

SUBDIVISION BLOCK / SECTION LOT LOT AREA AMPLE SITE CLASS PS DESIGN FLOW 480 L.T.A.R. ~~EXISTING~~ 0.4 CAD/AR

Septic Tank: ~~EXISTING~~ Gallons: STB Date

Pump Tank: Gallons: PT Date

Pump Make: Model Serial No.

Nitrification Field: No Fields 1 Square Feet 300 Linear Feet 100

No Lines 1 Trench Width 36" Max Trench Bottom Depth 36" Gravel Depth 12"

☒ New System ☐ Repair System Type: I (II) III. IV. V. VI

System Description: CONVENTIONAL GRAVITY

Repair System Description: CONV. GRAVITY

Maintenance Agreement Required: ☐ Yes ☒ No

☐ House/Mod. Home ☒ Mobile Home ☐ Business ☐ Other

☐ Slab ☐ Crawl Space ☒ Basement w/plumbing ☐ Basement wo/plumbing


No. Bedrooms 4 No. Bathrooms 2 No. Employees

Water Supply: ☒ Individual ☐ Public ☐ Community WELL


Comments:/Conditions: INSTALL NEW DROP BOX AT LOCATION SHOWN FEEDING NEW 3'X 100' LINE ON CONTOUR

Comments:/Conditions:

INITIAL SITE SKETCH

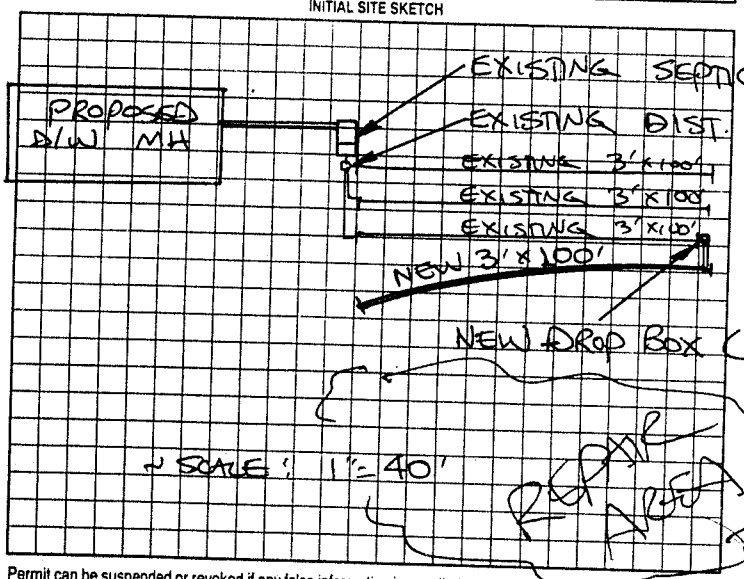

AS BUILT SKETCH

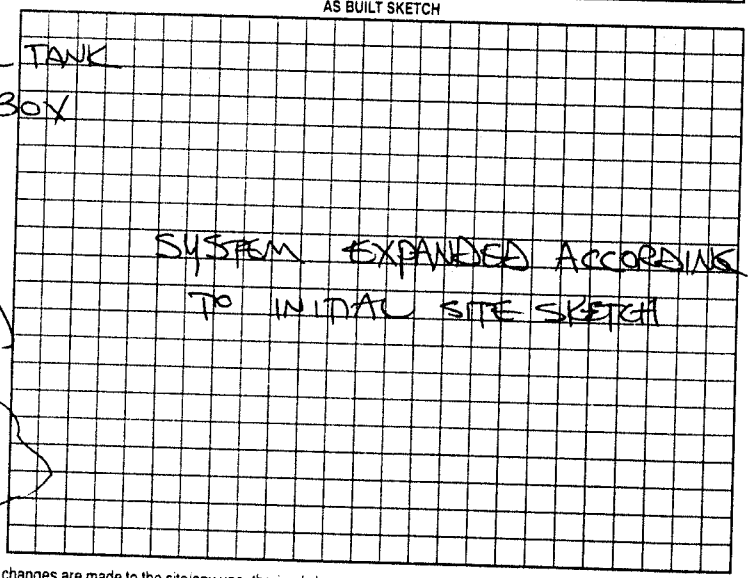

Permit can be suspended or revoked if any false information is supplied toward securing the permit/any unauthorized changes are made to the site/any unauthorized changes are made in the installation of the system. Improvement Permit with plat valid without expiration. Improvement Permit with site plan valid for sixty months. Authorization to Construct is valid for a period equal to that of Improvement Permit – not to exceed sixty months.

Signed: Roger D Sneed date 6-13-2000 Installed by: BRENT SALLITHER

Improvement Permit by: STEVE HENDRICK date 6-13-2000 Operation Permit by: STEVE HENDRICK date 6-23-2000

Authorization to Construct by: STEVE HENDRICK date 6-13-2000 Existing System Inspection by: date

HEALTH DEPT. COPY: WHITE OWNER COPY (FINAL): YELLOW OWNER COPY (INITIAL): PINK