IREDELL COUNTY HEALTH DEPARTMENT - *ENVIRONMENTAL HEALTH* ☐ STATESVILLE OFFICE 704-878-5305 ☐ MOORESVILLE OFFICE 704-664-5281

IMPROVEMENT PERMIT / AUTHORIZATION TO CONSTRUCT / OPERATION PERMIT / EXISTING SYSTEM INSPECTION

PERMIT # 167932 PIN # 4823-49-0164 DATE 16 August 2011

OWNER Joseph LeForge APPLICANT:

SITE ADDRESS 242 Fletcher Rd. Union Grove PHONE: Home/Cell # (704) 592-2210 Business #

SITE DIRECTIONS Hwy 115 N TR Fletcher Rd. House on RT. OWNER / APPLICANT ADDRESS

SUBDIVISION BLOCK / SECTION LOT # LOT AREA 1.13 Ac. DESIGN FLOW 240 g/d L.T.A.R. Exist.

Septic Tank Exist. Gallons: STB Date

Pump Tank Gallons: P T Date

Pump Make Model Serial #

No. Nitrification Fields: EX No. Lines EX Linear Feet Exist.

Trench Width EX Max. Trench Bottom Depth EX Gravel Depth EX

☐ New System ☐ Repair ☐ Expansion System Type I II III IV V VI

System Description: Exist. Gravel Trench

Repair System Description:

Maintenance Agreement Required ☐ YES ☒ NO

☒ GRAVITY ☐ PRESSURE

☒ Residence No. Bedrooms 2

☐ Business No. Persons

☐ Other No. Employees

☐ Slab ☐ Crawl Space


☒ Basement w/plumbing ☐ Basement w/o plumbing

Water Supply: ☒ Private ☐ Public ☐ Community

Comments / Conditions

* Reduction in bedrooms, - 3bR → 2bR
* Exist. system not visibly malfunctioning
* Does not encroach on well or existing syst.

INITIAL SITE SKETCH

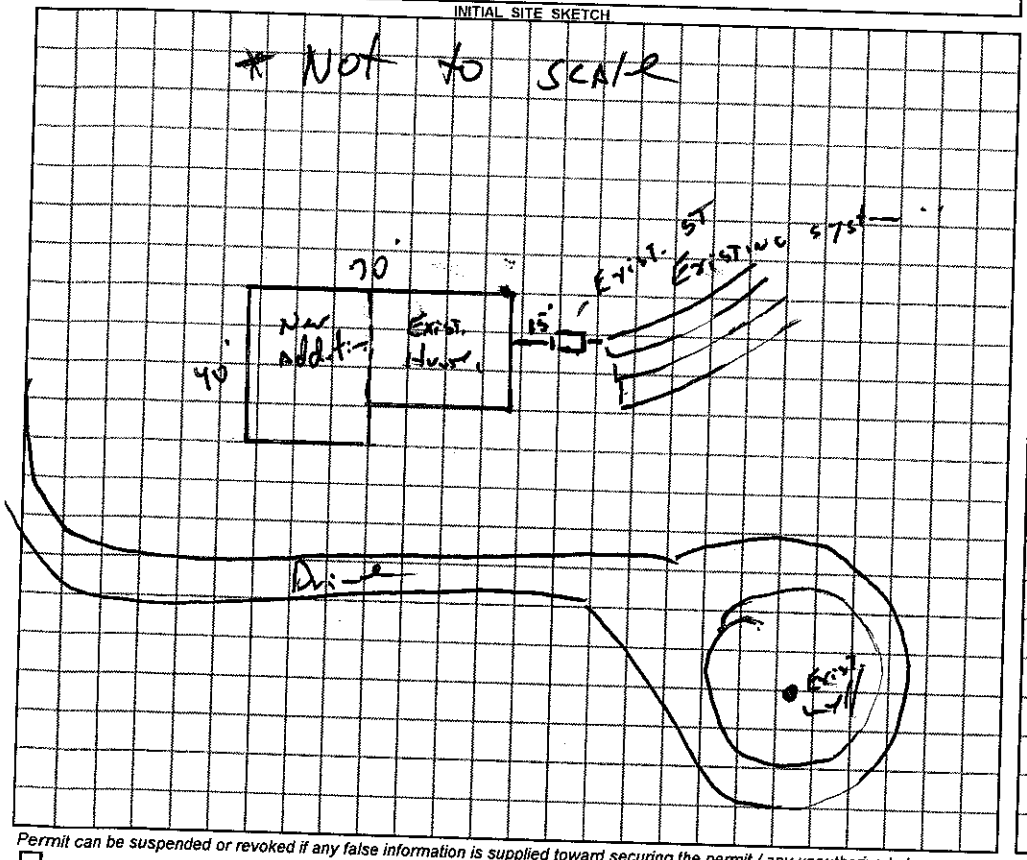

AS BUILT SKETCH

Permit can be suspended or revoked if any false information is supplied toward securing the permit / any unauthorized changes are made to the site / any unauthorized changes are made in the installation of the system.

☐ ***IMPROVEMENT PERMIT*** with plat valid without expiration. ☐ ***IMPROVEMENT PERMIT*** with plat valid without expiration. site plan valid 60 mo. ☐ ***AUTHORIZATION TO CONSTRUCT*** valid for period equal to IMPROVEMENT PERMIT--not to exceed 60 mo.

Owner / Applicant Signature: Joseph R. LeForge Date 8/24/11 Installed by:

IMPROVEMENT PERMIT by: REHS Date OPERATION PERMIT by: REHS Date

AUTHORIZATION TO CONSTRUCT by: REHS Date Existing System Inspected by: REHS Date 16 August 11

YOU SHOULD CONTACT A LOCATOR SERVICE PRIOR TO ANY EXCAVATION

White Copy – Environmental Health YELLOW COPY (Final) Owner / Applicant PINK COPY (Initial) Owner / Applicant