IREDELL COUNTY HEALTH DEPARTMENT

STATESVILLE 704-878-5305 MOORESVILLE 704-664-5281

IMPROVEMENT PERMIT / AUTHORIZATION TO CONSTRUCT / OPERATION PERMIT / EXISTING SYSTEM INSPECTION

PERMIT# 135094 PIN# 4823906896 495 293 DATE 8-10

OWNER OR CONTRACTOR Flossie Rives PHONE: Business 704 592 5259 Home 704 592 2458

ADDRESS 495 Morgan Ford Rd

LOCATION 115 N. @ Westglow Rd at end right Morgan Ford property on left

SUBDIVISION n/a BLOCK / SECTION n/a LOT LOT AREA 11.42 Acres SITE CLASS PS DESIGN FLOW 240 L.T.A.R. .3

Septic Tank: 1000 Gallons; STB 1012 Date 3-18-06
Pump Tank: Gallons; PT Date
Pump Make: Model Serial No.
Nitrification Field: No Fields 1 Square Feet 800 Linear Feet 200
No Lines 2 Trench Width 36" Max Trench Bottom Depth 36" Gravel Depth n/a

☒ New System ☐ Repair System Type: I (II) III IV V VI
System Description: 25% Reduction-Grav.
Repair System Description: 25% Reduction-Grav.
Maintenance Agreement Required: ☐ Yes ☒ No


☐ House/Mod. Home No. Bedrooms 2
☒ Mobile Home No. Bathrooms
☐ Business No. Employees
☐ Other
☐ Slab ☒ Crawl Space ☐ Basement w/plumbing ☐ Basement wo/plumbing

Water Supply:
☐ Individual
☐ Public
☒ Community

Comments:/Conditions:

Comments:/Conditions:
Yellow Filter
S/T Marker

INITIAL SITE SKETCH

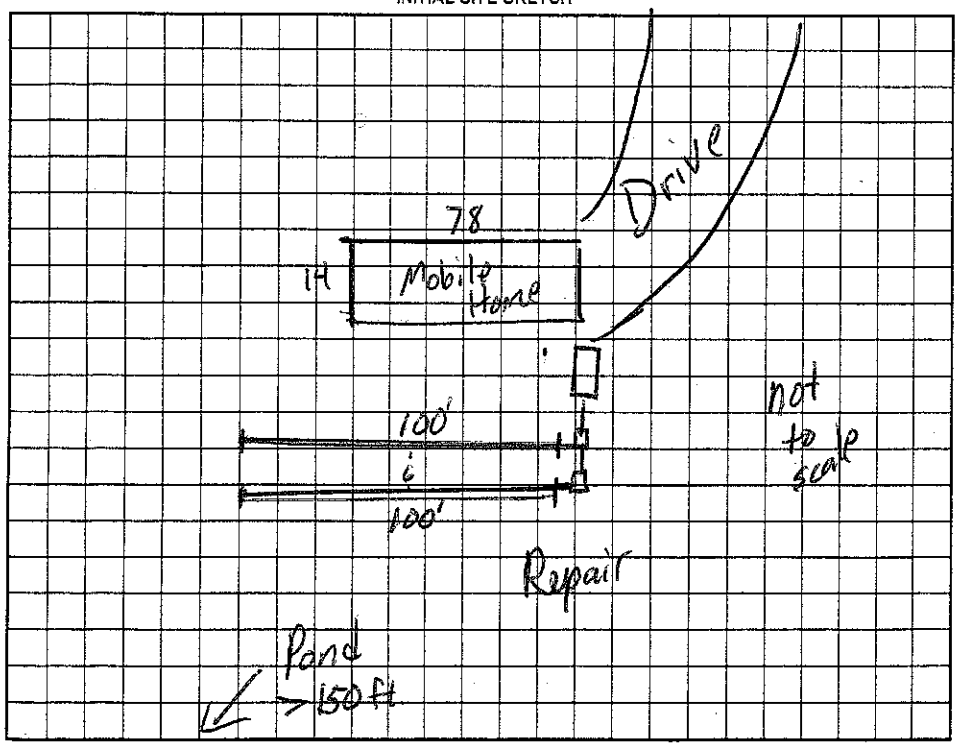

AS BUILT SKETCH

Permit can be suspended or revoked if any false information is supplied toward securing the permit/any unauthorized changes are made to the site/any unauthorized changes are made in the installation of the system. Improvement Permit with plat valid without expiration. Improvement Permit with site plan valid for sixty months. Authorization to Construct is valid for a period equal to that of Improvement Permit – not to exceed sixty months.

Signed: Dennis Gallihen date

Improvement Permit by: date 8-10-06

Authorization to Construct by: date 8-10-06

Installed by: A-1 Backhoe

Operation Permit by: date 8-10-06

Existing System Inspection by: date

HEALTH DEPT. COPY: WHITE OWNER COPY (FINAL): YELLOW OWNER COPY (INITIAL): PINK