IREDELL COUNTY HEALTH DEPARTMENT

STATESVILLE 704-878-5305 MOORESVILLE 704-664-5281

IMPROVEMENT PERMIT / AUTHORIZATION TO CONSTRUCT / OPERATION PERMIT / EXISTING SYSTEM INSPECTION

PERMIT# 082144 PIN# 4823 90 6896 DATE 7-9-99

OWNER OR CONTRACTOR JAMES REDMOND PHONE: Business Home 592-2941

ADDRESS 501 MORGAN FORD ROAD, STATESVILLE, NC 28625

LOCATION NC 115 N, TR WESTSIDE ROAD, TR MORGAN FORD ROAD, 1ST LOT ON LEFT

SUBDIVISION BLOCK / SECTION LOT LOT AREA 12.42 ACRES SITE CLASS PS DESIGN FLOW 360 L.T.A.R. 0.30 GPD/FT²

Septic Tank: 1000 Gallons; STB 786 Date

Pump Tank: Gallons; PT Date

Pump Make: Model Serial No.

Nitrification Field: No Fields 1 Square Feet 1200 Linear Feet 400

No Lines FOUR Trench Width 36" Max Trench Bottom Depth 36" Gravel Depth 12"

☑ New System ☐ Repair System Type: I (II) III IV V VI

System Description: CONVENTIONAL GRAVITY

Repair System Description: CONV. GRAVITY

Maintenance Agreement Required: ☐ Yes ☑ No

☐ House/Mod. Home ☑ Mobile Home ☐ Business ☐ Other

No. Bedrooms 3 No. Bathrooms 2 No. Employees


☐ Slab ☑ Crawl Space ☐ Basement w/plumbing ☐ Basement wo/plumbing

Water Supply: ☑ Individual ☐ Public ☐ Community WELL NEXT DOOR

Comments/Conditions: KEEP SYSTEM MINIMUM 10 FEET FROM WATER LINE

Comments/Conditions

INITIAL SITE SKETCH

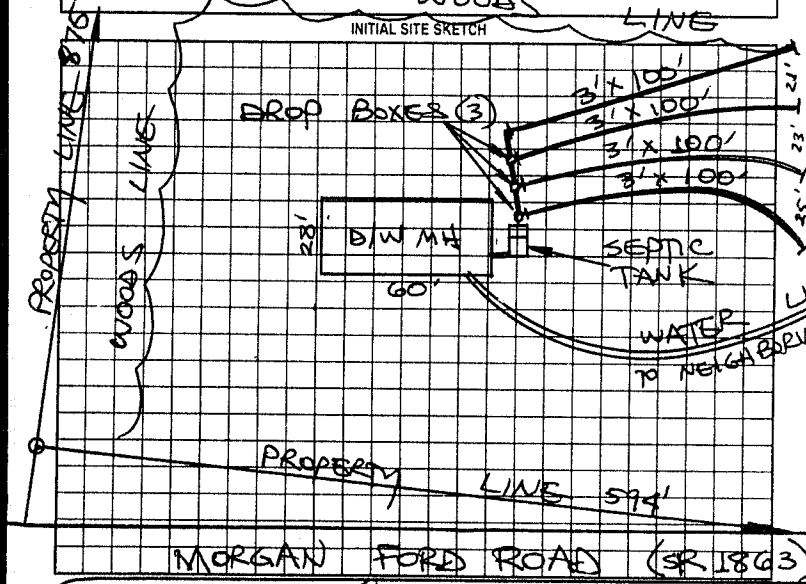

AS BUILT SKETCH

Permit can be suspended or revoked if any false information is supplied toward securing the permit/any unauthorized changes are made to the site/any unauthorized changes are made in the installation of the system. Improvement Permit with plat valid without expiration. Improvement Permit with site plan valid for sixty months. Authorization to Construct is valid for a period equal to that of Improvement Permit – not to exceed sixty months.

Signed: date 7-13-99 Installed by: G+M Enterprises

Improvement Permit by: STEVE HEDRICK date 7-9-99 Operation Permit by: Mat Cody, RS date 7-30-99

Authorization to Construct by: STEVE HEDRICK date 7-9-99 Existing System Inspection by: date

HEALTH DEPT COPY WHITE OWNER COPY (FINAL) YELLOW OWNER COPY (INITIAL) PINK