IREDELL COUNTY HEALTH DEPARTMENT

STATESVILLE 704-878-5305 MOORESVILLE 704-664-5281

IMPROVEMENT PERMIT / CERTIFICATE OF COMPLETION / OPERATION PERMIT / EXISTING SYSTEM INSPECTION

PROPERTY DESCRIPTION NO. 25286 DATE 3-7-97 TAX MAP NO. 15H-A-52

OWNER OR CONTRACTOR WILLIAM HOLLAND PHONE: Business Watershed: ☐ Yes ☑ No

ADDRESS P.O. BOX 62 UNION GROVE, NC 28689 Home 592-4849

LOCATION N C 115 N, TR NC 901, ON RIGHT AT BOX NUMBER 3877

SUBDIVISION BLOCK / SECTION LOT LOT AREA ~1.18 Ac SITE CLASS. PS DESIGN FLOW 240 L.T.A.R. 0.30 GPD/FT

Septic Tank: 1000 Gallons; STB 1012 Date 12-6-96

Pump Tank: Gallons; PT Date

Pump Make: Model Serial No.

Nitrification Field: No Fields 1 Square Feet 810 Linear Feet 270

No Lines THREE Trench Width 36 Max Trench Bottom Depth 36 Gravel Depth 12

☑ New System ☐ Repair System Type: I, II, III, IV, V, VI

System Description: CONVENTIONAL GRAVITY

Repair System Description: CONV. GRAVITY

Maintenance Agreement Required: ☐ Yes ☑ No

☐ House/Mod. Home ☑ Mobile Home ☐ Business ☐ Other

No. Bedrooms 2 No. Bathrooms 2 No. Employees


☐ Slab ☑ Crawl Space ☐ Basement w/plumbing ☐ Basement wo/plumbing

Water Supply: ☑ Individual ☐ Community ☐ Public WELL


Comments:

Comments: * Area at lot line wet

INITIAL SITE SKETCH

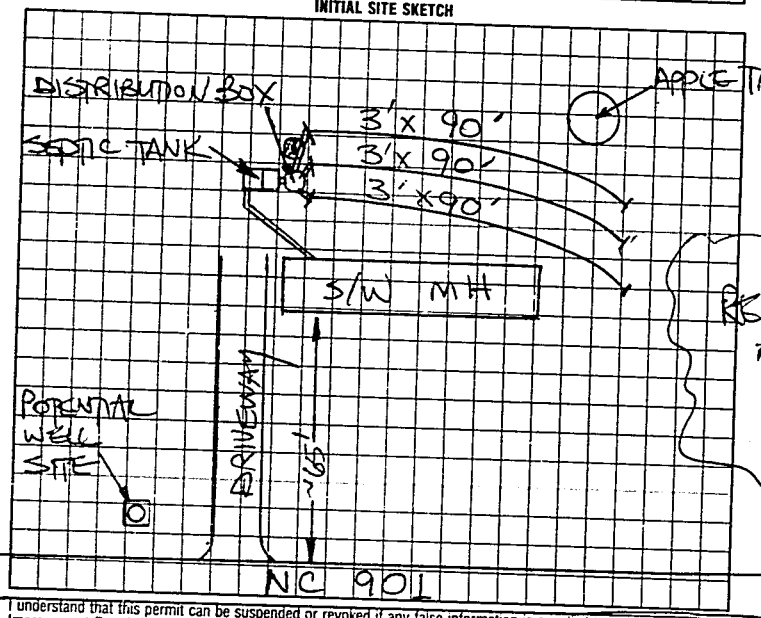

AS BUILT SKETCH

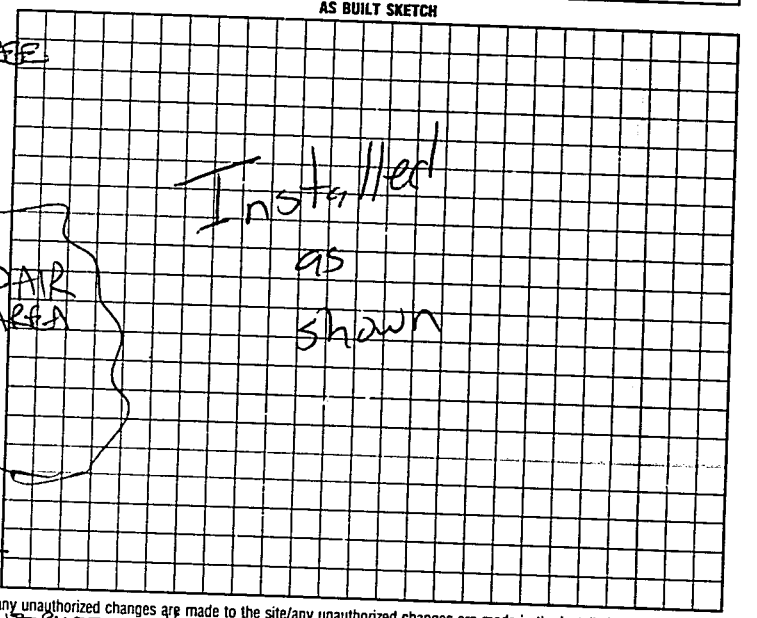

I understand that this permit can be suspended or revoked if any false information is supplied toward securing the permit/any unauthorized changes are made to the site/any unauthorized changes are made in the installation of the system. Improvement Permit is valid for 60 months from date of issuance. AUTHORIZATION TO CONSTRUCT IS VALID FOR 60 MONTH FROM ISSUANCE.

Signed: William Holland

Improvement Permit by: STEVE HEDRICK date 3-7-97

AUTH. TO CONST.

Existing System Inspection by: STEVE HEDRICK date 3-7-97

Installed by: Kenny Madison

~~Certificate of Completion~~ by:

Operation Permit by: Mark C. Outlaw date 3-24-97

HEALTH DEPT COPY: WHITE INSPECTION COPY (FINAL): GREEN OWNER COPY (FINAL): YELLOW INSPECTION COPY (INITIAL): PINK OWNER COPY (INITIAL): GOLD