IREDELL COUNTY HEALTH DEPARTMENT

STATESVILLE 704-878-5305 MOORESVILLE 704-664-5281

IMPROVEMENT PERMIT / AUTHORIZATION TO CONSTRUCT / OPERATION PERMIT / EXISTING SYSTEM INSPECTION

PERMIT# 124949 PIN# 4823-99-3553 DATE 1-28-05

OWNER OR CONTRACTOR PENNY R. WILLIAMS PHONE: Business (704) 902-5533 Home (704) 876-9998

ADDRESS 208 MOUNTAIN VIEW RD. STATESVILLE NC 28625

LOCATION I-77N TL HWY 901 (EXIT 65) TR GRASSY KNOB TL ZEB 1/4 MI ON LT. 0.25

SUBDIVISION _____ BLOCK / SECTION _____ LOT _____ LOT AREA 25.09 SITE CLASS. PS DESIGN FLOW 360 L.T.A.R. _____ gpd/ft²

Septic Tank: 1000 Gallons; STB 1012 Date 7-23-04
Pump Tank: _____ Gallons; PT _____ Date _____
Pump Make: _____ Model _____ Serial No. _____
Nitrification Field: No Fields 1 Square Feet 960 Linear Feet 320
No Lines 3 Trench Width 36" Max Trench Bottom Depth 36" Gravel Depth 12"

☑ New System ☐ Repair System Type: I, (II), III, IV, V, VI
System Description: CONVENTIONAL GRAVITY
Repair System Description: PUMP CONVENTIONAL
Maintenance Agreement Required: ☐ Yes ☑ No


☐ House/Mod. Home No. Bedrooms 2
☑ Mobile Home No. Bathrooms ____
☐ Business No. Employees ____
☐ Other _____
☐ Slab ☑ Crawl Space ☐ Basement w/plumbing ☐ Basement wo/plumbing

Water Supply: ☑ Individual ☐ Public ☐ Community

Comments:/Conditions: ① INSTALL LINES NO DEEPER THAN 36" ON CONTOUR ② SYSTEM WILL REQUIRE SUBSURFACE INTERCEPTOR DRAIN BE INSTALLED 48" TO DAYLIGHT ③ ELEVATION OF PLUMBING CRITICAL OR WILL HAVE TO PUMP

Comments:/Conditions: ④ MAINTAIN SETBACKS

INITIAL SITE SKETCH

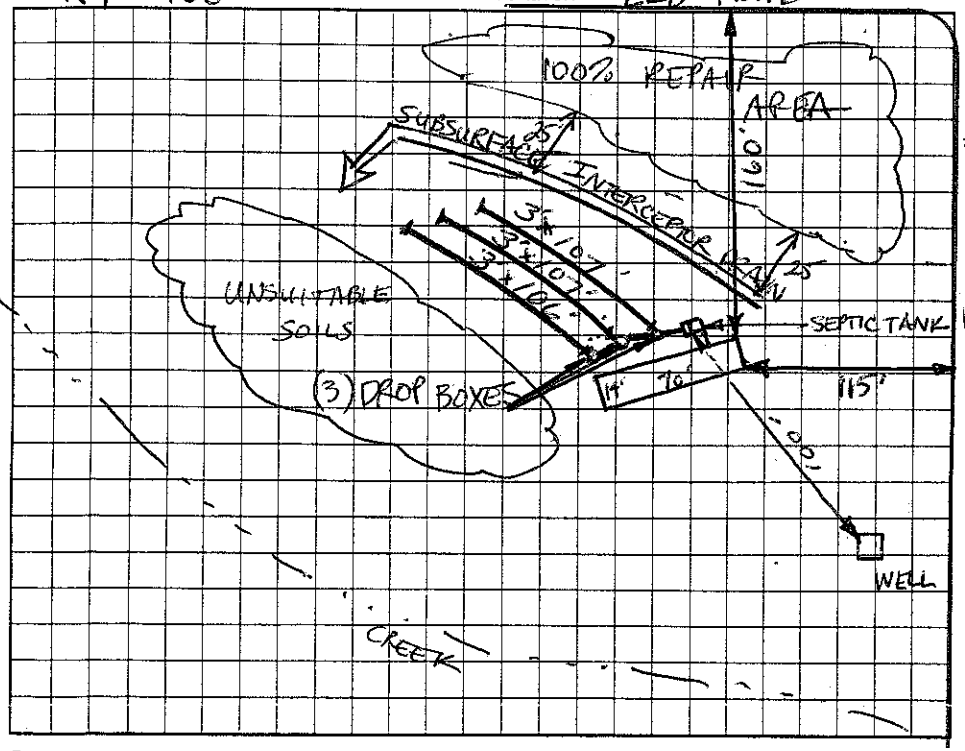

AS BUILT SKETCH

- TANK HAS "TUFF-TITE" FILTER & 18" RISER
- SYSTEM CONTAINS #57 STONE
- SYSTEM INSTALLED AS SHOWN
- * NOTE: WELL MOVED UP HILL BUT KEPT 100' FROM SYSTEM & REPAIR

Permit can be suspended or revoked if any false information is supplied toward securing the permit/any unauthorized changes are made to the site/any unauthorized changes are made in the installation of the system. Improvement Permit with plat valid without expiration. Improvement Permit with site plan valid for sixty months. Authorization to Construct is valid for a period equal to that of Improvement Permit – not to exceed sixty months.

Signed: _____ date 1-28-05 Installed by: A-1 BACK HOE

Improvement Permit by: Christopher M. Shell LS, LSS date 1-28-05 Operation Permit by: Christopher M. Shell LS, LSS date 2-9-05

Authorization to Construct by: Christopher M. Shell LS, LSS date 1-28-05 Existing System Inspection by: _____ date _____

HEALTH DEPT. COPY: WHITE OWNER COPY (FINAL): YELLOW OWNER COPY (INITIAL): PINK