IREDELL COUNTY HEALTH DEPARTMENT

Statesville Office (704) 878-5305 Mooresville Office (704) 660-3625 PERMIT # 208903

IMPROVEMENT PERMIT / AUTHORIZATION TO CONSTRUCT / OPERATION PERMIT / EXISTING SYSTEM

PIN # 4823999656

APPLICANT: Southwest Enterprises APPLICANT ADDRESS: 141 Oakstone Dr Statesville NC

SITE ADDRESS: 170 Zeb Rd PHONE: 704-239-3693 ALT. PHONE: 704-437-0739


SITE DIRECTIONS: 77 N exit 65 (0901 (R) Grassy Knob (L) Zeb Rd Property on right

SUBDIVISION: N/A SECTION: N/A LOT # N/A LOT AREA: 4.584ac DESIGN FLOW: 360 L.T.A.R.: 0.25


Septic Tank	1000 (gal)	STB	760-1000	Date	2-2	☑ New System ☐ Repair ☐ Expansion	System Type: I II III IV V VI	☑ Residence	No. Bedrooms	3	Water Supply
Pump Tank	(gal)	PT		Date		System Description:	25% Reduction	☐ Business	No. Persons	6	☒ Private
Pump Make		Model		Serial #		Repair System Description:	25% Reduction	☐ Other	No. Employees		☐ Public
# Nitrification Fields	1	# Lines	3	Linear Ft:	360	Maintenance Agreement Required:	☐ YES ☒ NO	☐ Slab	☑ Crawl Space		☐ Community
Trench Width	36"	Max. Trench Bottom Depth	36"	Gravel Depth	N/A	☒ GRAVITY	☐ PRESSURE	☐ Basement w/plumbing		☐ Basement w/o plumbing	

Comments / Conditions: Install 25% on contour with serial distribution.

INITIAL SITE SKETCH

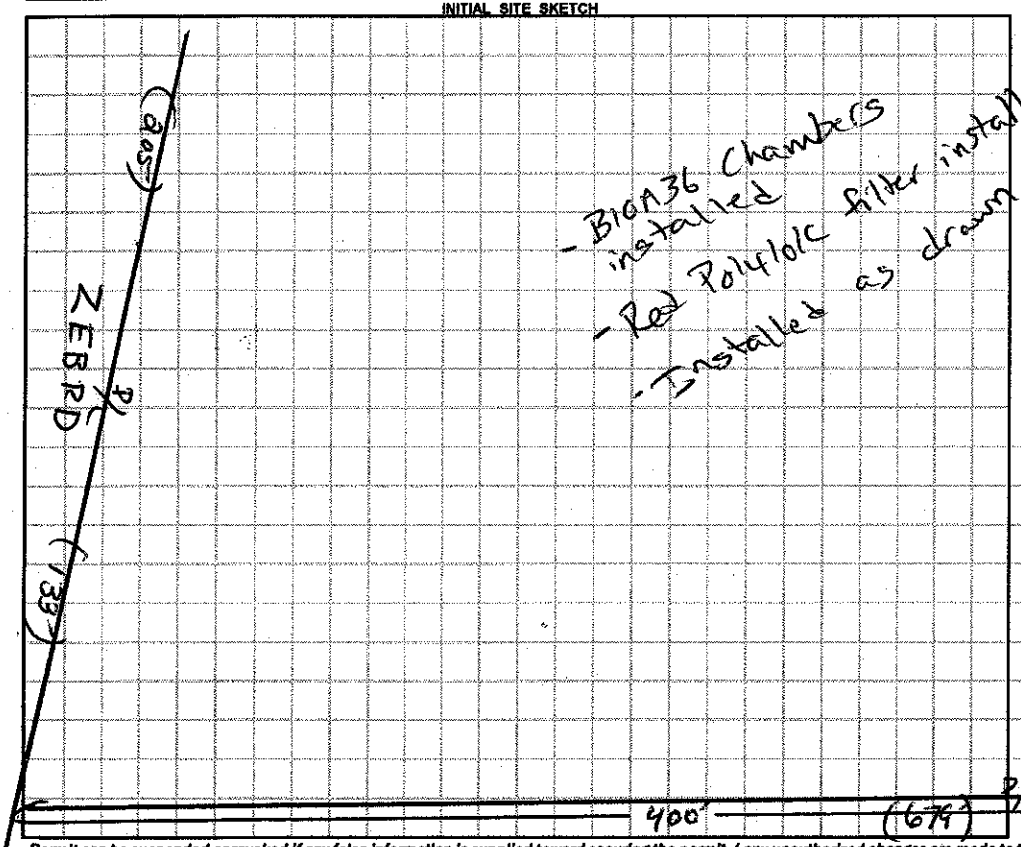

AS BUILT SKETCH

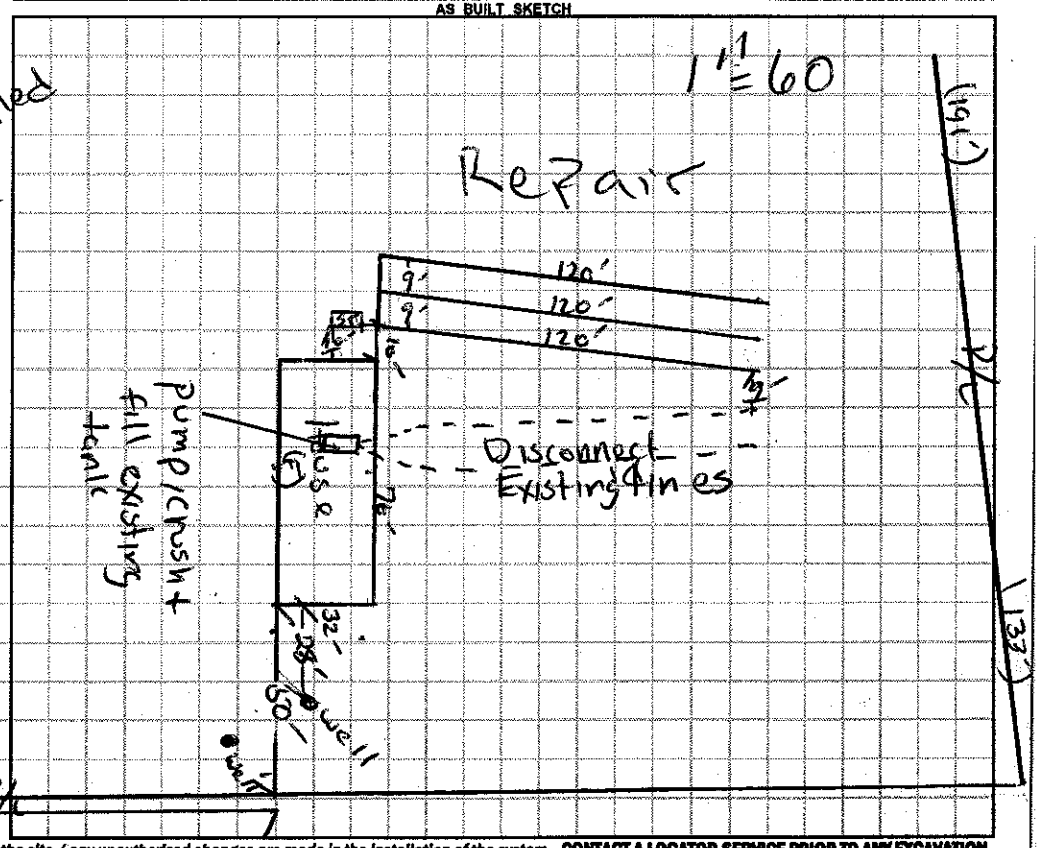

Permit can be suspended or revoked if any false information is supplied toward securing the permit / any unauthorized changes are made to the site / any unauthorized changes are made in the installation of the system. **CONTACT A LOCATOR SERVICE PRIOR TO ANY EXCAVATION**

☐ **IMPROVEMENT PERMIT** *with plat* valid without expiration. ☒ **IMPROVEMENT PERMIT** *with site plan* valid for 60 mos. ☒ **AUTHORIZATION TO CONSTRUCT** valid for period equal to IMPROVEMENT PERMIT--not to exceed 60 mo.

Owner / Applicant Signature: [signature] Date: 5/26/15 Installed by: Tim Abee

IMPROVEMENT PERMIT by: [signature] Date: 05/26/15 OPERATION PERMIT by: Justin Henderson Date: 4-20-16

AUTHORIZATION TO CONSTRUCT by: [signature] Date: 05/26/15 Existing System Inspected by: Date:

Health Dept. Copy - WHITE Applicant (Final Approval) - YELLOW Applicant (Conditional Approval) - PINK