IREDELL COUNTY HEALTH DEPARTMENT (C1) STATESVILLE 704-878-5305 (C1) MOORESVILLE 704-664-5281

IMPROVEMENT PERMIT / AUTHORIZATION TO CONSTRUCT / OPERATION PERMIT / EXISTING SYSTEM INSPECTION

PERMIT# 103432 PIN# 4824-00-3596 DATE 12-5-01

OWNER OR CONTRACTOR BRENT & ANGELA BALDWIN PHONE Business _____ Home (704) 592-2185

ADDRESS 6221 WILKESBORO Hwy, UNION GROVE, NC 28689

LOCATION NC 115 N, N 1 MILE NORTH of NC901, ON LEFT BACK OFF ROAD AT Box # 6221

SUBDIVISION _____ BLOCK / SECTION _____ LOT _____ LOT AREA 2.6 ACRES SITE CLASS PS DESIGN FLOW 480 L.T.A.R. 0.40 GPD/FT²

Septic Tank: 1000 Gallons: STB 760 Date 1-22-02
Pump Tank: _____ Gallons: PT _____ Date _____
Pump Make: _____ Model _____ Serial No _____
Nitrification Field: No Fields 1 Square Feet 1200 Linear Feet 400
No Lines FIVE Trench Width 36" Max Trench Bottom Depth 36 Gravel Depth 12"

✓ New System ☐ Repair System Type: I II III IV V VI
System Description: CONVENTIONAL GRAVITY
Repair System Description: CONV. GRAVITY
Maintenance Agreement Required ☐ Yes ✓ No

✓ House/Mod Home No Bedrooms 4
☐ Mobile Home No Bathrooms 2½
☐ Business No Employees _____
☐ Other _____


✓ Slab ☐ Crawl Space ☐ Basement w/plumbing ☐ Basement wo/plumbing

Water Supply: ✓ Individual ☐ Public ☐ Community WELL

Comments/Conditions: KEEP SYSTEM MINIMUM 100' FROM WELL

Comments/Conditions: SEPTIC TANK WITH RISERS INSTALLED USING "ZABEL" FILTER

INITIAL SITE SKETCH

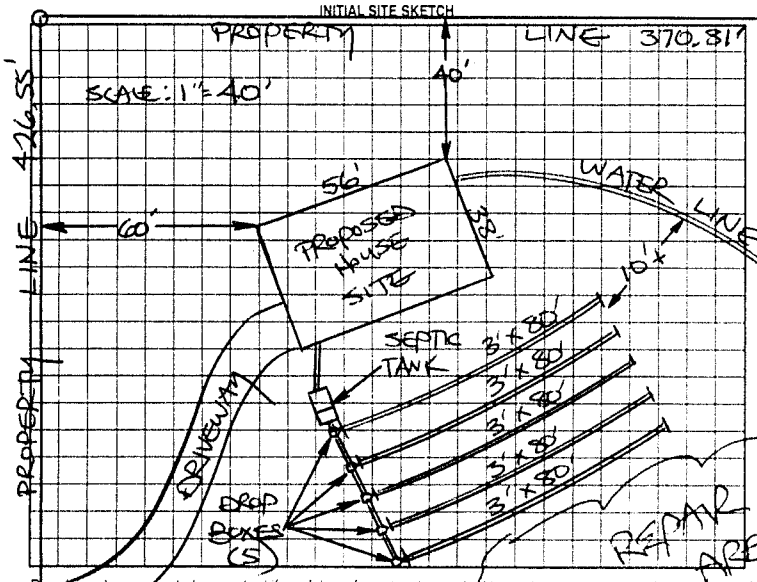

AS BUILT SKETCH

SYSTEM INSTALLED ACCORDING TO INITAL SITE SKETCH

Permit can be suspended or revoked if any false information is supplied toward securing the permit, any unauthorized changes are made to the site, any unauthorized changes are made in the installation of the system. Improvement Permit with plat valid without expiration. Improvement Permit with site plan valid for sixty months. Authorization to Construct is valid for a period equal to that of Improvement Permit – not to exceed sixty months.

Signed: X Kevin Brent Baldwin date 12/5/01 Installed by BRENT GALLIHER

Improvement Permit by: STEVE HEDRICK date 12-5-01 Operation Permit by: STEVE HEDRICK date 4-26-02

Authorization to Construct by: STEVE HEDRICK date 12-5-01 Existing System Inspection by _____ date _____

HEALTH DEPT COPY: WHITE OWNER COPY (FINAL): YELLOW OWNER COPY (INITIAL): PINK