IREDELL COUNTY HEALTH DEPARTMENT

Statesville Phone TR 3-7271 Mooresville Phone NO 3-1271

PERMIT TO INSTALL SEPTIC TANK

Permit NO. Lunsford Sta Permit Date July 22 1963

Owner T.T. Alexander Address 115 N

Installed By C Hoke Address R7.


Location of Property New Tepco Sta before Wilkes line on R. old Lunsford Sta.

Tank	Capacity	Length of Lines	Fixtures
Block ( )	800 ( )	150' ( )	No. of Baths (2) stools
Precast (✓)	900 ( )	175' ( )	Dishwasher ( )
	1000 (✓)	200' ( )	Garbage Grdr. ( )
	1100 ( )	225' (✓)	Auto-Washer ( )
	1200 ( )	250' ( )	Other
	Other	Other	

NOTIFY HEALTH DEPARTMENT AT LEAST EIGHT HOURS BEFORE TANK IS TO BE INSPECTED.

Final Inspection 7-22 1963 Approved (✓) Disapproved ( )

Remarks

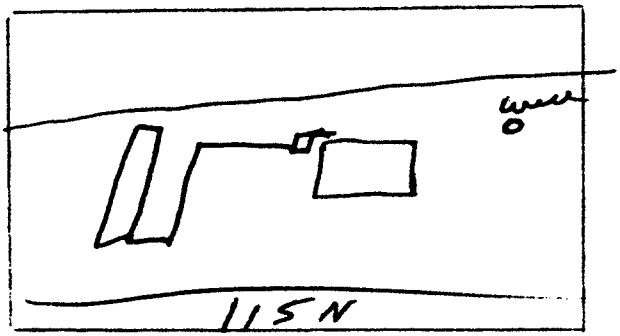

Sketch of Installation

Sanitarian