IREDELL COUNTY HEALTH DEPARTMENT

STATESVILLE 704-878-5305 MOORESVILLE 704-664-5281

IMPROVEMENT PERMIT / CERTIFICATE OF COMPLETION / OPERATION PERMIT / EXISTING SYSTEM INSPECTION

PROPERTY DESCRIPTION NO. 16669 DATE 7/19/93 TAX MAP NO. 15P-A-24A

OWNER OR CONTRACTOR MARY A. JOHNSON, CTR CO. PHONE: Business 872-2172 Home

ADDRESS RT-1 BOX 254 UNION GROVE, NC 28689

LOCATION NC 115 N, TR ZEB ROAD, CTR ON L, AMPLE, LAST BUILDING ON L

SUBDIVISION BLOCK / SECTION LOT LOT AREA SITE CLASS PS L.T.A.R. ~0.4 GPD/FT²

Water Supply: ✓ Individual ☐ Community ☐ Public

Septic Tank: EXISTING Gallons; STB Date

Pump Tank: Gallons; PT Date

Nitrification Field: No Fields Square Feet Linear Feet EXISTING

No Lines Trench Width Trench Depth Gravel Depth /

☐ New System ☐ Repair System Type: I II III IV V VI

System Description: CONV, GRAVITY

Repair System Description:

Maintenance Agreement Required: ☐ Yes ✓ No

☐ House/Mod. Home ☐ Mobile Home ✓ Business SHOP ☐ Other

No. Bedrooms No. Bathrooms No. Employees 10 MAX.

✓ Slab ☐ Crawl Space ☐ Basement w/plumbing ☐ Basement wo/plumbing

Garbage Disposal: ☐ Yes ☐ ~~No~~


Auto. Dishwasher: ☐ Yes ☐ ~~No~~

Auto. Washing Machine: ☐ Yes ☐ ~~No~~


Other

Comments (1) SYSTEM DESIGNED FOR 2 BR MH; MH NOW REMOVED.

INITIAL SITE SKETCH

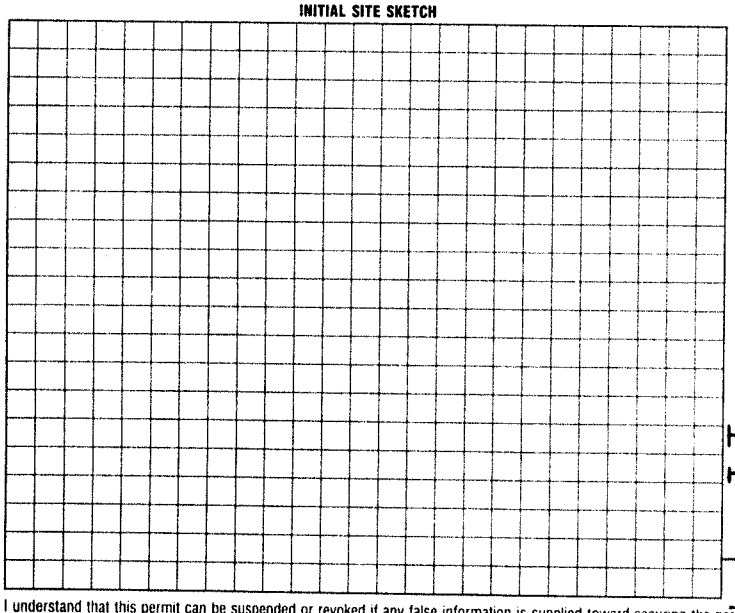

AS BUILT SKETCH

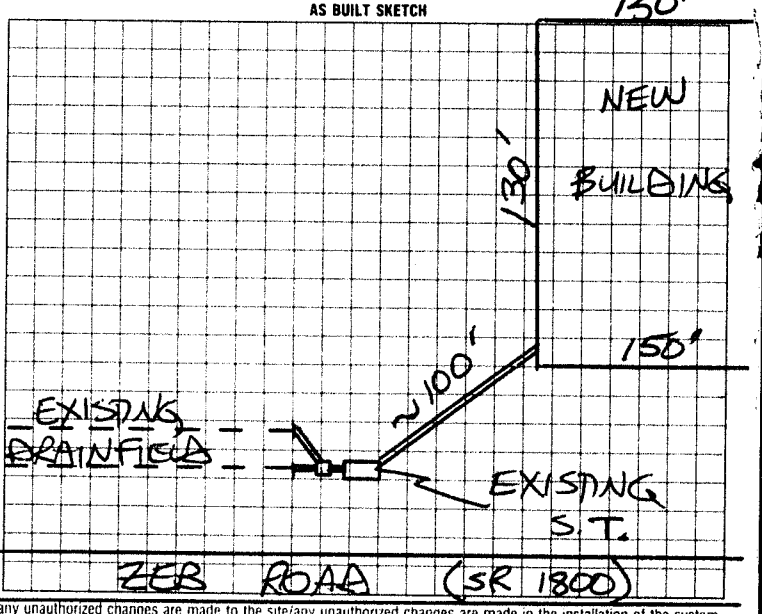

I understand that this permit can be suspended or revoked if any false information is supplied toward securing the permit/any unauthorized changes are made to the site/any unauthorized changes are made in the installation of the system. Improvement Permit is valid for 60 months from date of issuance.

Signed:

Improvement Permit by: date

Existing System Inspection by: STEVE HEDRICK date 7/19/93

Installed by

Certificate of Completion by date

Operation Permit by date

HEALTH DEPT. COPY: WHITE INSPECTION COPY (FINAL): GREEN OWNER COPY (FINAL): YELLOW INSPECTION COPY (INITIAL): PINK OWNER COPY (INITIAL): GOLD