IREDELL COUNTY HEALTH DEPARTMENT

STATESVILLE 704-878-5305 MOORESVILLE 704-664-5281

IMPROVEMENT PERMIT / AUTHORIZATION TO CONSTRUCT / OPERATION PERMIT / EXISTING SYSTEM INSPECTION

PERMIT# 116394 PIN# 4824-11-2459

OWNER OR CONTRACTOR DWAYNE LUNSFORD DATE 11-6-03

ADDRESS 144 PICKERSVILLE LANE UNION GROVE, NC 28689 PHONE: Business 704-876-1696 Home 704-592-2420

LOCATION 115 NORTH (R) NICHOLSON HILL (L) PICKERSVILLE DR AT END ON LT UP ON HILL

SUBDIVISION _____ BLOCK / SECTION _____ LOT _____ LOT AREA 1.79AC SITE CLASS. PS DESIGN FLOW 360 L.T.A.R. .3

Septic Tank: 1000 Gallons; STB 1012 Date 6-21-03

Pump Tank: _____ Gallons; PT _____ Date _____

Pump Make: _____ Model _____ Serial No. _____

Nitrification Field: No Fields 1 Square Feet EQ=1200 Linear Feet 360'

No Lines 5x60' Trench Width 36" Max Trench Bottom Depth 36" Gravel Depth N/A

☒ New System ☐ Repair System Type: I, II, (III) IV, V, VI

System Description: GRAV 25%RED

Repair System Description: LP PANEL

Maintenance Agreement Required: ☐ Yes ☒ No

☑ House/Mod. Home No. Bedrooms 3

☒ Mobile Home SW No. Bathrooms 2

☐ Business No. Employees ____

☐ Other _____

☐ Slab ☒ Crawl Space ☐ Basement w/plumbing ☐ Basement wo/plumbing


Water Supply: ☒ Individual ☐ Public ☐ Community

Comments:/Conditions: (1) SYSTEM & HOUSE IS COMPLETELY FLAGGED OUT (2) INSTALL LINES ON CONTOURS, (3) MAINTAIN SETBACKS (4) DUKE POWER APPROVED USAGE OF POWERLINE EASEMENT. DOES NOT HAVE NOT TO SCALE"


Comments:/Conditions: A R/O/W, Tuff-Tite Filter

Note: Some alterations to system made

INITIAL SITE SKETCH

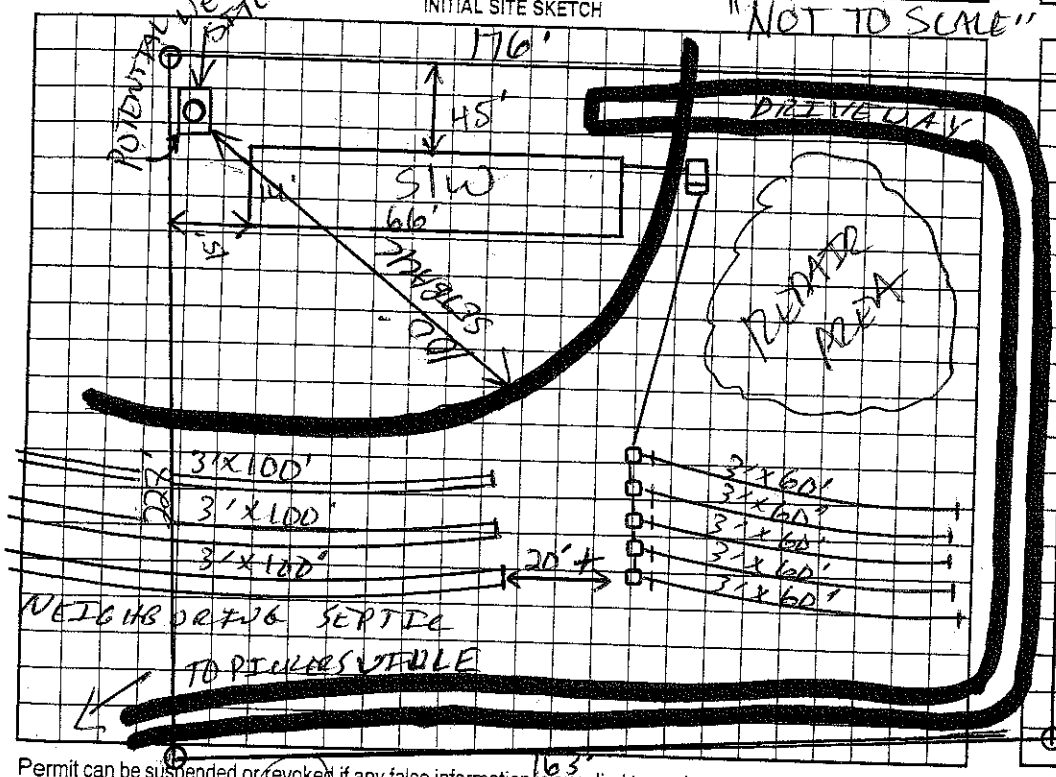

AS BUILT SKETCH

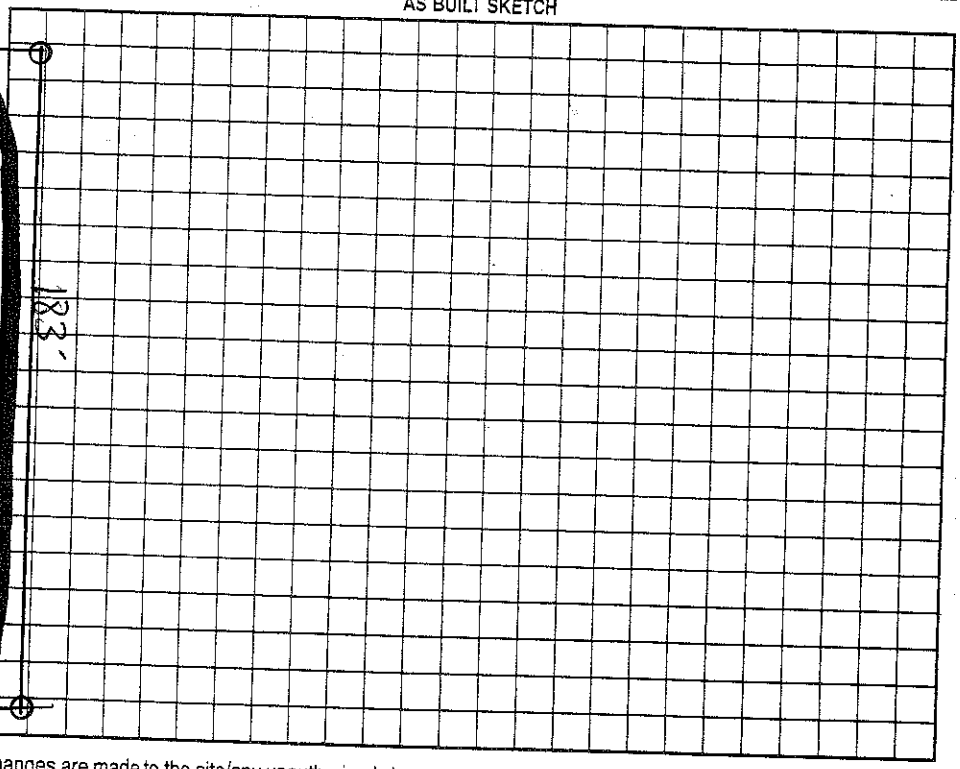

Permit can be suspended or revoked if any false information is supplied toward securing the permit/any unauthorized changes are made to the site/any unauthorized changes are made in the installation of the system. Improvement Permit with plat valid without expiration. Improvement Permit with site plan valid for sixty months. Authorization to Construct is valid for a period equal to that of Improvement Permit – not to exceed sixty months.

Signed: Carrie Johnson date 11-10-03 Installed by: Craig Thompson (Cody)

Improvement Permit by: _____ date 11-6-03 Operation Permit by: Christopher M. Hamil, RS date 12-29-03

Authorization to Construct by: _____ date 11-6-03 Existing System Inspection by: _____ date _____

HEALTH DEPT. COPY: WHITE OWNER COPY (FINAL): YELLOW OWNER COPY (INITIAL): PINK