STEVE JORDAN 704-902-2891

THIS SYSTEM DID NOT HAVE FRENCH DRAIN INSTALLED.
STEVE JORDAN & STEVE HEDRICK & DWAYNE LUNSFORD VERIFIED

IREDELL COUNTY HEALTH DEPARTMENT

STATESVILLE 704-878-5305 MOORESVILLE 704-664-5281

IMPROVEMENT PERMIT / AUTHORIZATION TO CONSTRUCT / OPERATION PERMIT / EXISTING SYSTEM INSPECTION

PERMIT# 103025 PIN# 4824-12-1095 DATE 11-05-01

OWNER OR CONTRACTOR DWAYNE LUNSFORD PHONE Business (704) 876-1696 Home (704) 592-2420

ADDRESS 144 PICKERSVILLE DRIVE, UNION GROVE, NC 28689

LOCATION NC 115 N, TR NICHOLSON HILL, TL PICKERSVILLE DR, AT END ON RIGHT

SUBDIVISION _____ BLOCK / SECTION _____ LOT _____ LOT AREA 4.56 ACRES SITE CLASS PS DESIGN FLOW 360 L.T.A.R. 0.40 GPD/FT²

Septic Tank: 1000 Gallons STB 1017 Date 10-01-01
Pump Tank: 1000 Gallons PT 17 Date 3-5-01
Pump Make: GOULDS Model WE05H Serial No L0166901
Nitrification Field: No Fields 1 Square Feet 900 Linear Feet 300
No Lines THREE Trench Width 36" Max Trench Bottom Depth 28"

✓ New System Repair System Type I II (III) IV V
System Description CONVENTIONAL, PUMP
Repair System Description: MAXIMUM FEASIBLE
Maintenance Agreement Required Yes (No)

✓ House/Mod. Home No. Bedrooms 3
Mobile Home No. Bathrooms 2
Business No. Employees ____
Other ____


Gravel Depth 12" Slab ✓ Crawl Space Basement w/plumbing Basement w/o plumbing

Water Supply: ✓ Individual ☐ Public ☐ Community WELL NEXT DOOR


Comments/Conditions: ① INSTALL SUBSURFACE INTERCEPT DRAINAGE DITCH AT LOCATION SHOWN BEGINNING 40" DEEP CUT TO DAYLIGHT ② SEE ATTACHED SHEETS FOR PUMP & PRESSURE MANIFOLD REQUIREMENTS ③ ABANDON EXISTING SEPTIC SYSTEM.

Comments Corrections SEPTIC TANK W/ MARKER INSTALLED USING "POLY LOK" FILTER

INITIAL SITE SKETCH 42" DEEP

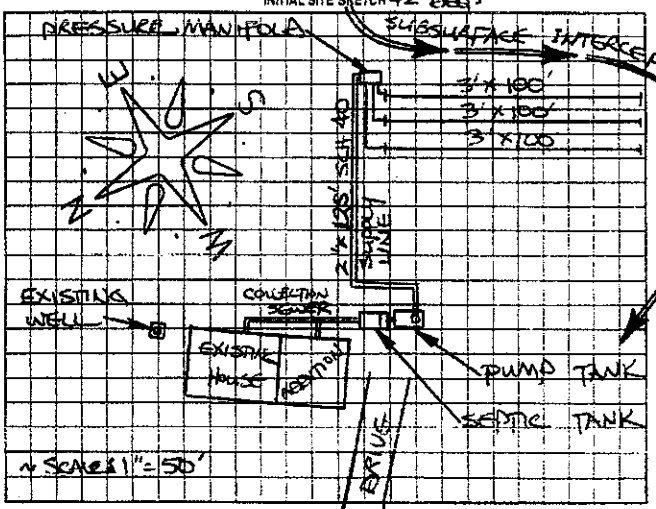

AS BUILT SKETCH

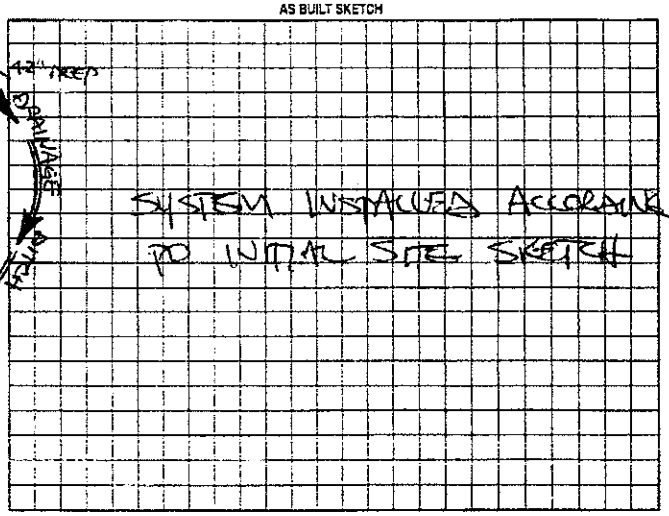

Permit can be suspended or revoked if any false information is supplied toward securing the permit; any unauthorized changes are made to the site; any unauthorized changes are made in the installation of the system. Improvement Permit with plat valid without expiration. Improvement Permit with site plan valid for sixty months. Authorization to Construct is valid for a period equal to that of Improvement Permit - not to exceed sixty months.

Signed: Dwayne E. Lunsford date 11-08-01 Installed by: STEVE JORDAN

Improvement Permit by: STEVE HEDRICK date 11-05-01 Operation Permit by: STEVE HEDRICK date 1-18-02

Authorization to Construct by: STEVE HEDRICK date 11-05-01 Existing System Inspection by: _____ date _____

HEALTH DEPT COPY: WHITE OWNER COPY: FINAL: YELLOW OWNER COPY: INITIAL: PINK

JAN. 1, 1989 2:57