IREDELL COUNTY HEALTH DEPARTMENT

STATESVILLE 704-878-5305 MOORESVILLE 704-664-5281

IMPROVEMENT PERMIT / AUTHORIZATION TO CONSTRUCT / OPERATION PERMIT / EXISTING SYSTEM INSPECTION

PERMIT# 079693 PIN# 4824 30 9521 DATE 3-19-99

OWNER OR CONTRACTOR WILLIAM HALL PHONE: Business Home 592-5053

ADDRESS 146 LIGHTHOUSE DRIVE, UNION GROVE, NC 28689

LOCATION NC 115 N, TR FLETCHER, TL LIGHTHOUSE DRIVE, BEAR LEFT TO END

SUBDIVISION BLOCK / SECTION LOT LOT AREA 11.58 ACRES SITE CLASS. PS DESIGN FLOW 240 L.T.A.R. 0.30 sqft/ft²

Septic Tank: 1000 Gallons; STB 6072 Date 2-30-01
Pump Tank: Gallons; PT Date
Pump Make: Model Serial No.
Nitrification Field: No Fields 1 Square Feet 810 Linear Feet 270
No Lines TWO Trench Width 36" Max Trench Bottom Depth 36"

☑ New System ☐ Repair System Type: ☐ II ☐ III, IV, V, VI
System Description: CONVENTIONAL GRAVITY
Repair System Description: CONV. GRAVITY
Maintenance Agreement Required: ☐ Yes ☑ No
Gravel Depth 12" ☑ Slab ☐ Crawl Space ☐ Basement w/plumbing ☐ Basement wo/plumbing

☑ House/Mod. Home No. Bedrooms 2
☐ Mobile Home No. Bathrooms 1
☐ Business No. Employees
☐ Other


Water Supply: ☑ Individual ☐ Public ☐ Community
WELL

Comments/Conditions:


Comments/Conditions: - Poly Loc filter Installed
- S.T. Risers Installed

SCALE: 1"=40'

INITIAL SITE SKETCH

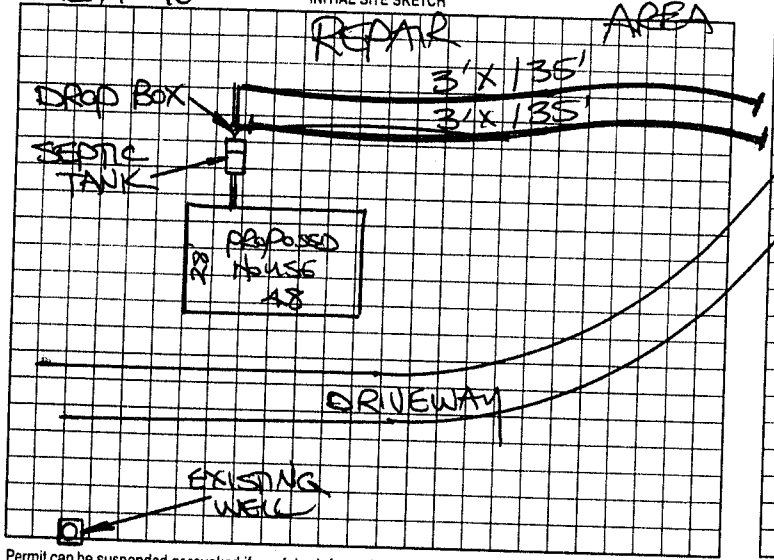

AS BUILT SKETCH

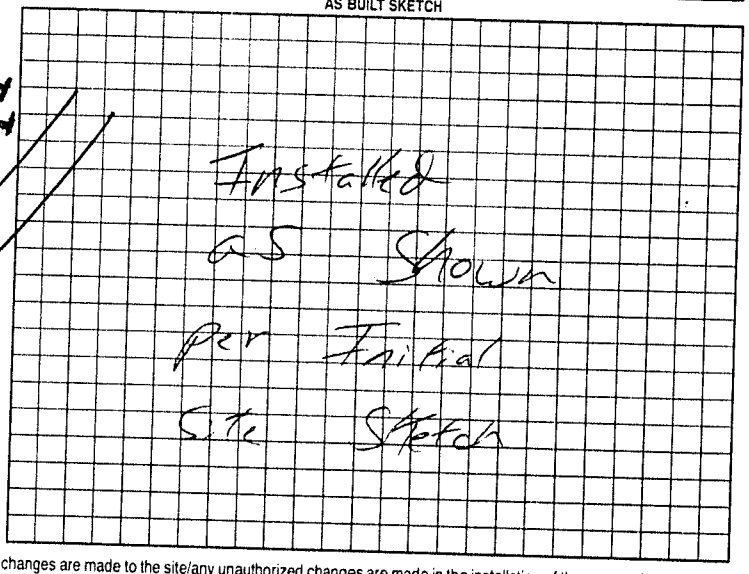

Permit can be suspended or revoked if any false information is supplied toward securing the permit/any unauthorized changes are made to the site/any unauthorized changes are made in the installation of the system. Improvement Permit with plat valid without expiration. Improvement Permit with site plan valid for sixty months. Authorization to Construct is valid for a period equal to that of Improvement Permit – not to exceed sixty months.

Signed: †William Sm. Hall date 3-19-99

Improvement Permit by: STEVE HEDRICK date 3.19.99

Authorization to Construct by: STEVE HEDRICK date 3-19-99

Installed by: William Hall

Operation Permit by: William E. Johnson date 4/17/02

Existing System Inspection by: date

HEALTH DEPT COPY: WHITE OWNER COPY (FINAL): YELLOW OWNER COPY (INITIAL): PINK