IREDELL COUNTY HEALTH DEPARTMENT

STATESVILLE 704-878-5305 MOORESVILLE 704-664-5281

IMPROVEMENT PERMIT / AUTHORIZATION TO CONSTRUCT / OPERATION PERMIT / EXISTING SYSTEM INSPECTION

PERMIT# 100427 PIN# 4824 33 1634 DATE 5-24-01

OWNER OR CONTRACTOR JOHN N. CRAWFORD, JR PHONE: Business _____ Home (704) 592-2477

ADDRESS 613 ZEB ROAD, UNION GROVE, NC. 28689

LOCATION NC 115 NORTH, TR ZEB ROAD, 1ON RIGHT ACROSS FROM McCARTER RD

SUBDIVISION _____ BLOCK / SECTION _____ LOT _____ LOT AREA 3.0 ACRES SITE CLASS. P5 DESIGN FLOW 360 L.T.A.R. 0.33 (EXISTING)

Septic Tank: EXISTING Gallons; STB _____ Date _____
Pump Tank: _____ Gallons; PT _____ Date _____
Pump Make: _____ Model _____ Serial No. _____
Nitrification Field: No Fields 1 Square Feet 360 Linear Feet 120
No Lines 1 Trench Width 36" Max Trench Bottom Depth 36" Gravel Depth 12"

☑ New System ☐ Repair System Type: I (II) III IV V VI
System Description: CONVENTIONAL GRAVITY
Repair System Description: CONV. GRAVITY
Maintenance Agreement Required: ☐ Yes ☑ No
☐ Slab ☑ Crawl Space ☐ Basement w/plumbing ☐ Basement wo/plumbing


☑ House/Mod. Home No. Bedrooms 3
☐ Mobile Home No. Bathrooms 2
☐ Business No. Employees _____
☐ Other _____

Water Supply: ☑ Individual ☐ Public ☐ Community
WELL

Comments:/Conditions: ① INSTALL NEW 3'x120' LINE ON CONTOUR
② ADJUST DIST. BOX FOR SERIAL DISTRIBUTION
③ EXISTING S/W MH TO BE REMOVED UPON OCCUPANCY OF HOUSE.

Comments:/Conditions:

INITIAL SITE SKETCH

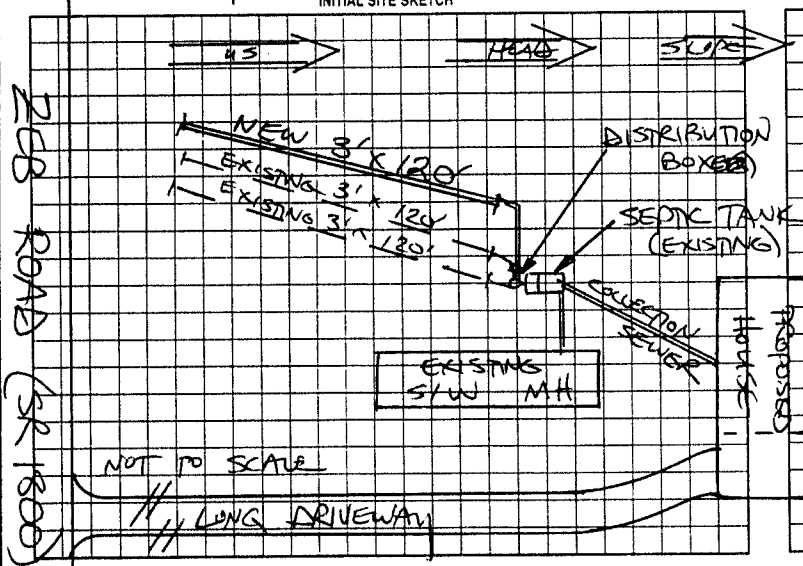

AS BUILT SKETCH

SYSTEM EXPANDED ACCORDING TO INITAL SITE SKETCH

Permit can be suspended or revoked if any false information is supplied toward securing the permit/any unauthorized changes are made to the site/any unauthorized changes are made in the installation of the system. Improvement Permit with plat valid without expiration. Improvement Permit with site plan valid for sixty months. Authorization to Construct is valid for a period equal to that of Improvement Permit – not to exceed sixty months.

Signed: Steve Hedrick date 5-24-01 Installed by: DAVID YOUNTZ

Improvement Permit by: STEVE HEDRICK date 5-24-01 Operation Permit by: STEVE HEDRICK date 8-27-01

Authorization to Construct by: STEVE HEDRICK date 5-24-01 Existing System Inspection by: _____ date _____

HEALTH DEPT COPY: WHITE OWNER COPY (FINAL): YELLOW OWNER COPY (INITIAL): PINK