4-06

IREDELL COUNTY HEALTH DEPARTMENT

STATESVILLE 704-878-5305 (a) MOORESVILLE 704-664-5281

IMPROVEMENT PERMIT / AUTHORIZATION TO CONSTRUCT / OPERATION PERMIT / EXISTING SYSTEM INSPECTION

PERMIT # 59943 PIN # 4824438310 DATE 3-10-10

OWNER or APPLICANT Ray & Natalie Balzer PHONE: Business Home: 704-881-2232

OWNER or APPLICANT ADDRESS 324 Zeb Rd Union Grove, NC 28689

LOCATION / DIRECTIONS 15N TR Zeb Road on left (2nd house on left after Pavement ends)

SUBDIVISION BLOCK / SECTION LOT # LOT AREA 1.805 DESIGN FLOW 360 L.T.A.R. 125

Septic Tank 1000 Gallons: STB 1000 Date 9-8-08
Pump Tank Gallons: P T Date
Pump Make Model Serial #
Nitrification Field No Fields 1 No Lines 4 Linear Feet 360'
Trench Width 36" Max. Trench Bottom Depth 36" Gravel Depth N/A

☑ New System ☐ Repair ☐ Expansion System Type I II III IV V VI
System Description: 2500 Gal Tank
Repair System Description: 50% Initial Sys
Maintenance Agreement Required ☐ YES ☑ NO
☑ GRAVITY ☐ PRESSURE

☑ Residence No. Bedrooms 3
☐ Business No. Persons
☐ Other No. Employees
☐ Slab ☐ Crawl Space
☑ Basement w/plumbing ☐ Basement w/o plumbing


Water Supply: ☑ Private ☐ Public ☐ Community

Comments / Conditions
1. Maintain all setbacks
2. Install on contour
3. Maintain all setbacks with water line

INITIAL SITE SKETCH

Comments / Conditions
(1" = 100')

AS BUILT SKETCH

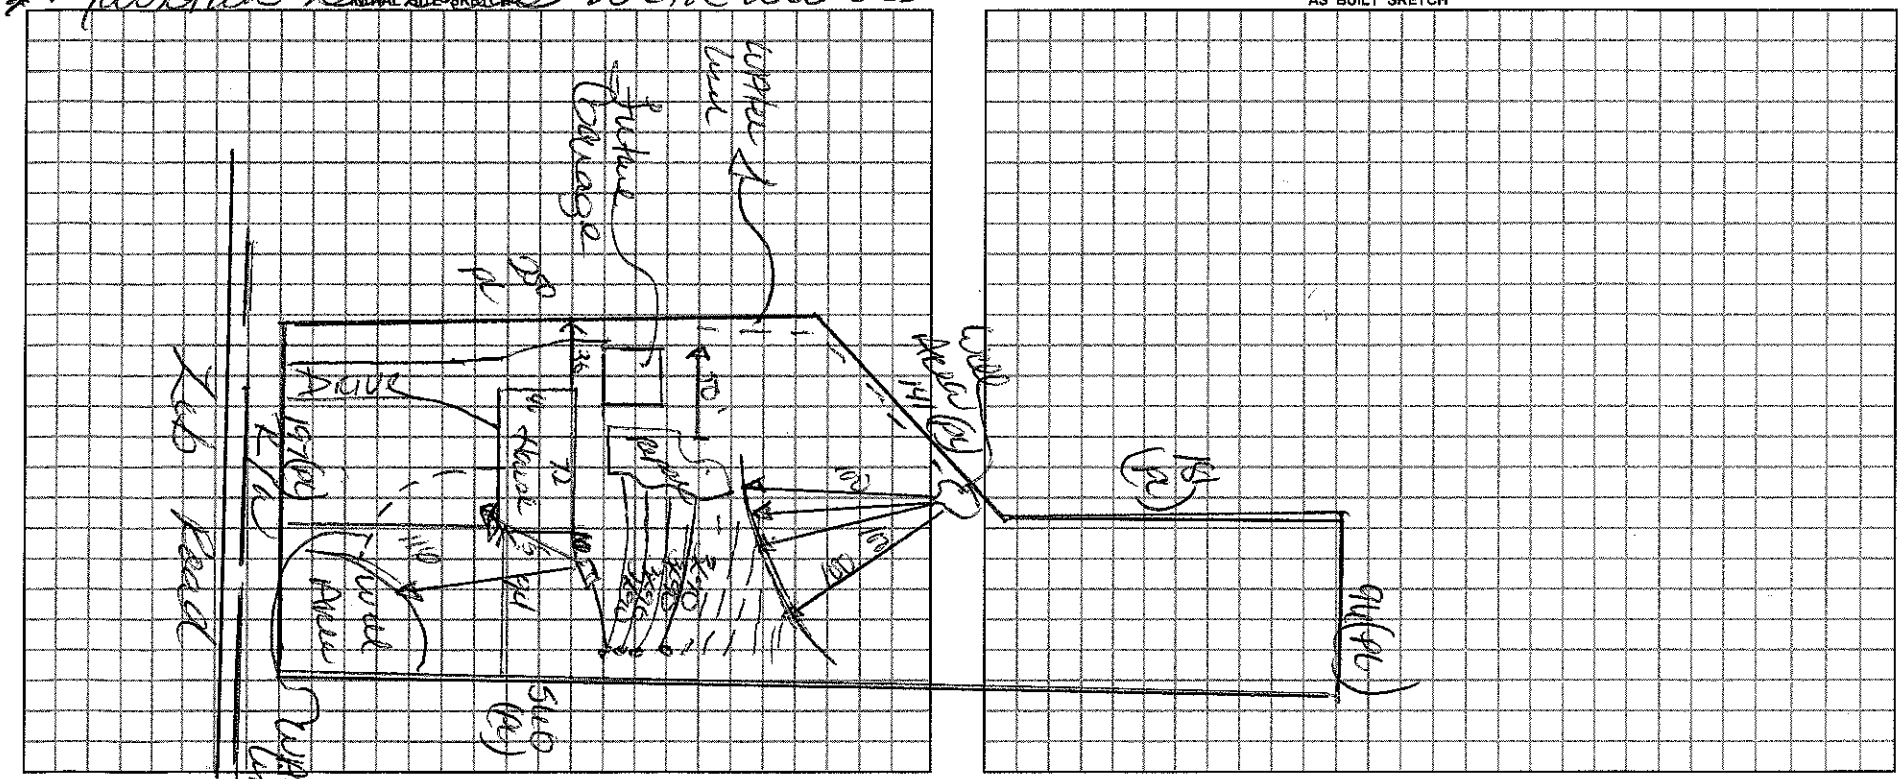

Permit can be suspended or revoked if any false information is supplied toward securing the permit / any unauthorized changes are made to the site / any unauthorized changes are made in the installation of the system.

☐ IMPROVEMENT PERMIT w / plat valid without expiration. ☑ IMPROVEMENT PERMIT w / site plan valid for 60 mos. ☑ AUTHORIZATION TO CONSTRUCT valid for period equal to IMPROVEMENT PERMIT-not to exceed 60 mo.

Owner / Applicant Signature: Brian Shelmore Date 3-12-10
Improvement Permit by: Date 3-10-10
Authorization to Construct by: Date 3-10-10

Installed by: Gunner Grading
Operation Permit by: Date: 3-30-10
Existing System Inspected by: Date:

YOU SHOULD CONTACT A LOCATOR SERVICE PRIOR TO ANY EXCAVATION.

WHITE COPY Environmental Health YELLOW COPY (Final) Owner / Applicant PINK COPY (Initial) Owner / Applicant