22105

IREDELL COUNTY HEALTH DEPARTMENT

STATESVILLE 704-878-5305 MOORESVILLE 704-664-5281

IMPROVEMENT PERMIT / CERTIFICATE OF COMPLETION / OPERATION PERMIT / EXISTING SYSTEM INSPECTION

PROPERTY DESCRIPTION NO. 22105 DATE 9-20-95 TAX MAP NO. 15J-A-67

OWNER OR CONTRACTOR THEODORE G. SUMMERVILLE PHONE: Business ______ Home (704)483-6902 Watershed: ☐ Yes ☑ No

ADDRESS 7962 UNITY CH. RD. DENVER, NC 28037

LOCATION NC 115 N, TR FLETCHER RD, LOT ON LEFT JUST BEFORE ZEB ROAD

SUBDIVISION Jerry Arnold Southern BLOCK / SECTION ______ LOT 1 LOT AREA 2.25 Ac SITE CLASS. PS DESIGN FLOW 360 L.T.A.R. 0.35 GPD/FT²

Septic Tank: 1000 Gallons; STB 854 Date 2-28-96
Pump Tank: ______ Gallons; PT ______ Date ______
Pump Make: ______ Model ______ Serial No. ______
Nitrification Field: No Fields 1 Square Feet 1035 Linear Feet 345
No Lines 4 Trench Width 36" Max Trench Bottom Depth 18-36" Gravel Depth 12"

☑ New System ☐ Repair System Type: I, II, III, IV, V, VI (I circled)
System Description: CONVENTIONAL GRAVITY
Repair System Description: CONV. GRAVITY
Maintenance Agreement Required: ☐ Yes ☑ No
☐ Slab ☑ Crawl Space ☐ Basement w/plumbing ☐ Basement wo/plumbing


☐ House/Mod. Home ☑ Mobile Home ☐ Business ☐ Other ______
No. Bedrooms 3 No. Bathrooms 2 No. Employees ______

Water Supply: ☑ Individual ☐ Community ☐ Public
WELL


Comments: ① KEEP SYSTEM MINIMUM 100' FROM WELL, 10' FROM PROPERTY LINE ② INSTALL LINES ON CONTOUR NO DEEPER THAN 36", 9' MIN. APART ON CENTER ③ USE SCH 80 PVC BENEATH DRIVEWAY

Comments: DISTRIBUTION CHANGED TO FLOW DIVIDER TEES DUE TO DRAINLINES BEING INSTALLED OUT OF CONTOUR

INITIAL SITE SKETCH

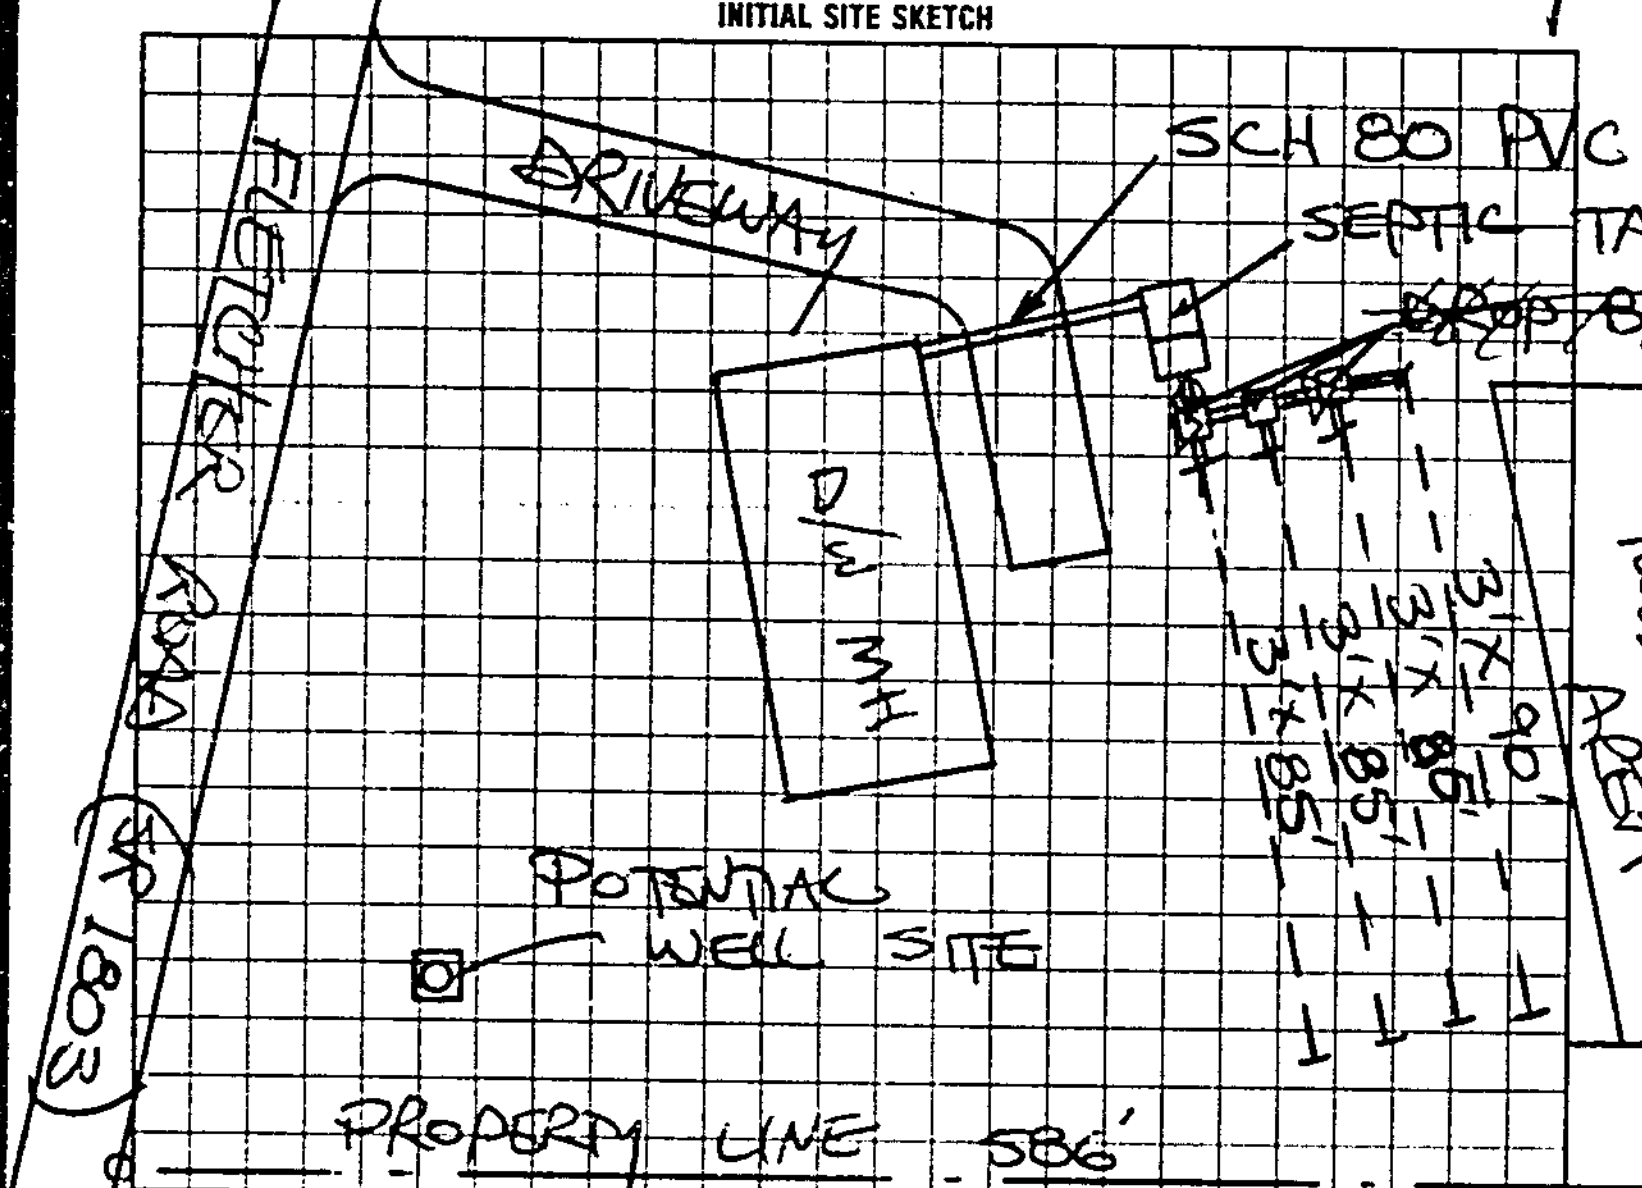

AS BUILT SKETCH

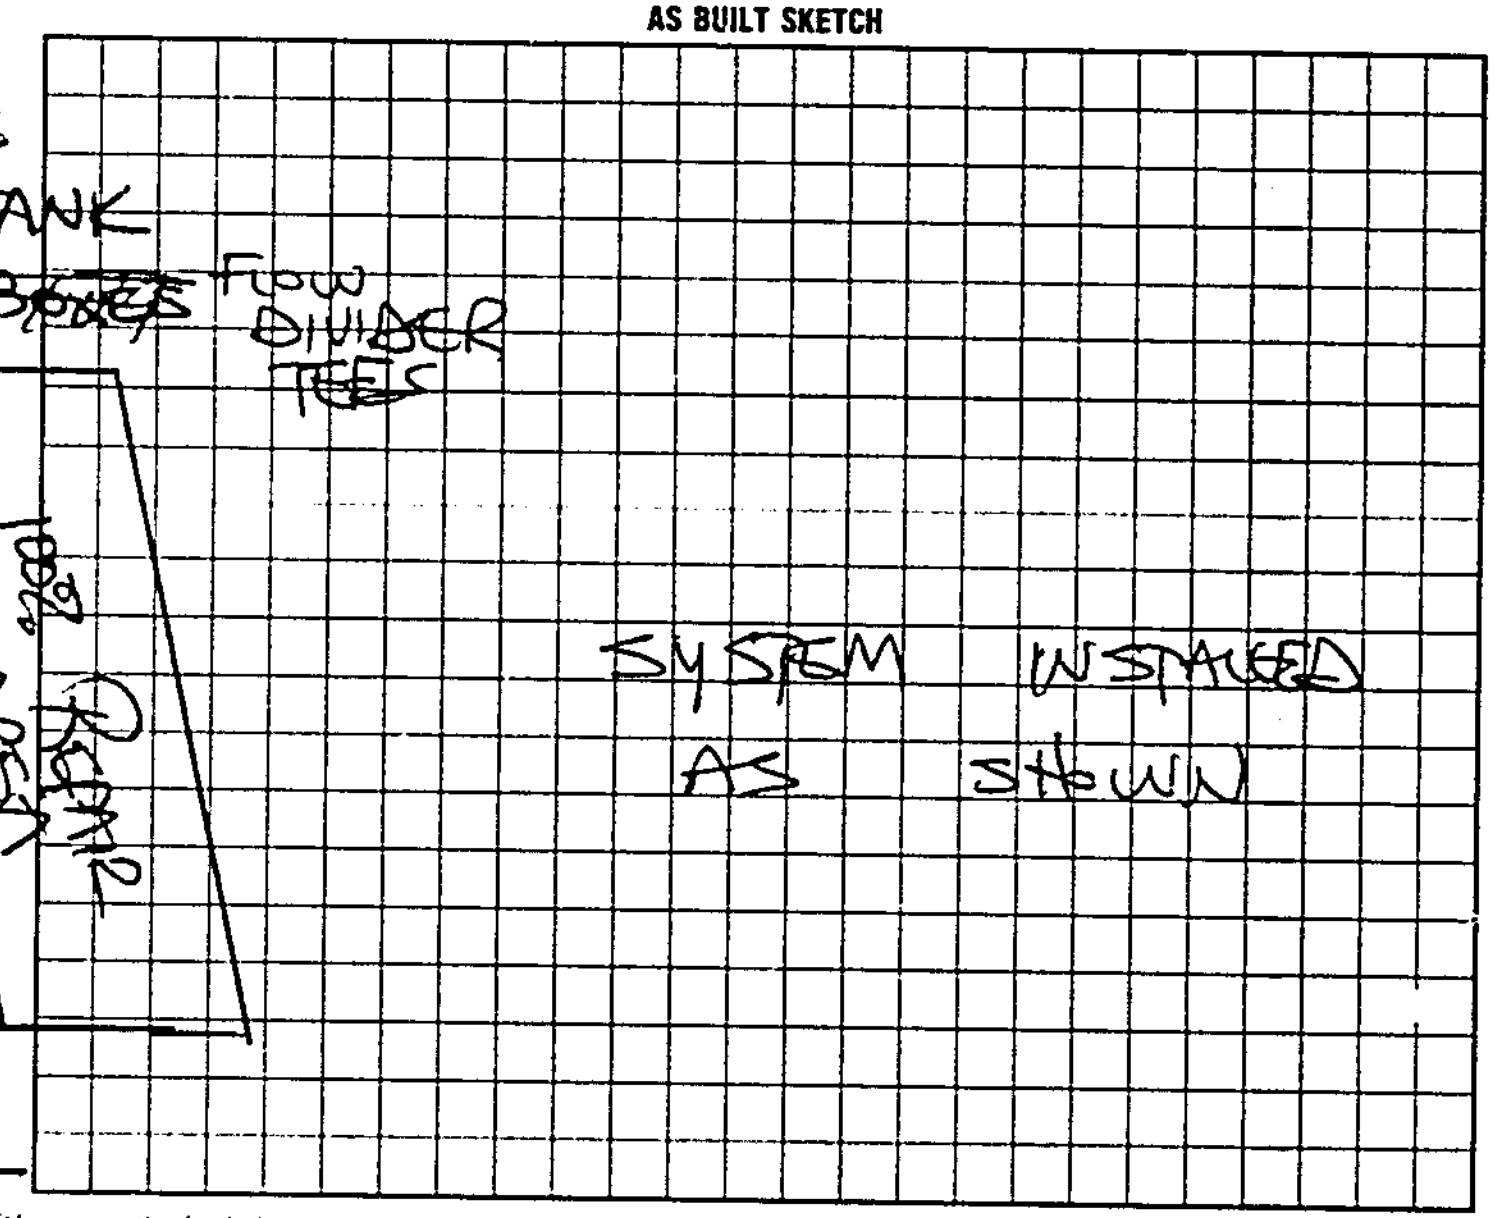

I understand that this permit can be suspended or revoked if any false information is supplied toward securing the permit/any unauthorized changes are made to the site/any unauthorized changes are made in the installation of the system.

Signed: + Leroy Templeton

Installed by: JEFF HURLBUTT

Improvement Permit by: STEVE HEDRICK date 9-20-95

Certificate of Completion by: ______ date ______

Existing System Inspection by: ______ date ______

Operation Permit by: STEVE HEDRICK date 7-25-96

HEALTH DEPT. COPY WHITE INSPECTION COPY (FINAL) GREEN OWNER COPY (FINAL) YELLOW INSPECTION COPY (INITIAL) PINK OWNER COPY (INITIAL) GOLD

0 0 2 3 8 2