# IREDELL COUNTY HEALTH DEPARTMENT

STATESVILLE 704-878-5305 (C) MOORESVILLE 704-664-5281

## IMPROVEMENT PERMIT / AUTHORIZATION TO CONSTRUCT / OPERATION PERMIT / EXISTING SYSTEM INSPECTION

PERMIT# 106653 PIN# 4824-50-2378 DATE 6-26-02

OWNER OR CONTRACTOR JOHN ANDERSON PHONE Business Home 704-592-4968

ADDRESS P.O. BOX 100 UNION GROVE, NC 28689

LOCATION NC 115 North, TR' FLETCHER ROAD, ~ 2 MILES ON RIGHT AT BOX # 328

SUBDIVISION GLASSY KNOB BLOCK / SECTION LOT 2 LOT AREA 2.09 ACRE SITE CLASS PS DESIGN FLOW 360 LTAR 0.30 GPD/FT²

Septic Tank: 1000 Gallons: STB 1012 Date 4-30-02
Pump Tank: Gallons: PT Date
Pump Make: Model Serial No
Nitrification Field: No Fields 1 Square Feet 1200 Linear Feet 400
No Lines FOUR Trench Width 36" Max Trench Bottom Depth 30" Gravel Depth 12"

✓ New System Repair System Type: I (II) III IV V
System Description: CONVENTIONAL GRAVITY
Repair System Description: CONVENTIONAL GRAVITY
Maintenance Agreement Required: Yes ✓ No
Slab ✓ Crawl Space Basement w/plumbing Basement wo/plumbing


✓ House/Mod Home No Bedrooms 3
Mobile Home No Bathrooms 2
Business No Employees
Other

Water Supply: ✓ Individual ☐ Public ☐ Community
WELL

Comments/Conditions:

Comments/Conditions: SEPTIC TANK WITH MARKER INSTALLED USING "TUFTITE" FILTER

INITIAL SITE SKETCH

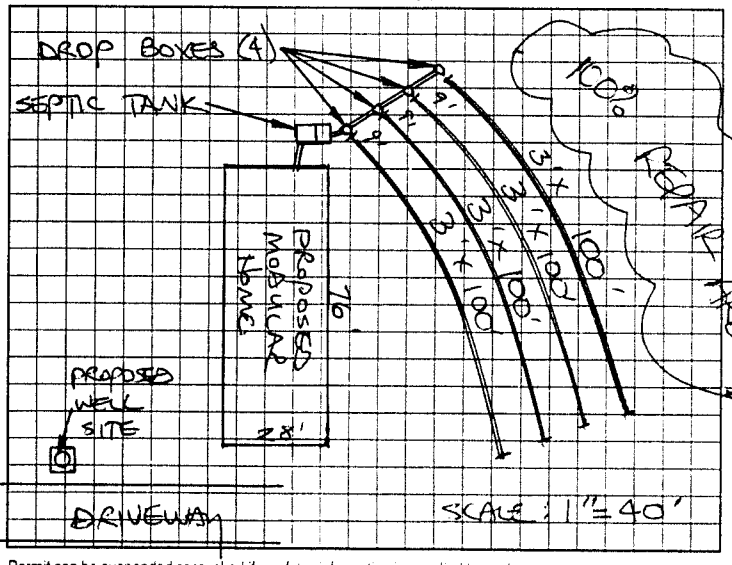


AS BUILT SKETCH

SYSTEM INSTALLED ACCORDING TO INITIAL SITE SKETCH

Permit can be suspended or revoked if any false information is supplied toward securing the permit, any unauthorized changes are made to the site, any unauthorized changes are made in the installation of the system. Improvement Permit with plat valid without expiration. Improvement Permit with site plan valid for sixty months. Authorization to Construct is valid for a period equal to that of Improvement Permit – not to exceed sixty months.

Signed: [signature] date 6-26-02 Installed by: JEFF HURLBUT

Improvement Permit by: STEVE HEDRICK date 6-26-02 Operation Permit by: STEVE HEDRICK date 9-6-02

Authorization to Construct by: STEVE HEDRICK date 6-26-02 Existing System Inspection by: date

HEALTH DEPT COPY WHITE OWNER COPY (FINAL) YELLOW OWNER COPY (INITIAL) PINK