IREDELL COUNTY HEALTH DEPARTMENT

STATESVILLE 704-878-5305 MOORESVILLE 704-664-5281

IMPROVEMENT PERMIT / CERTIFICATE OF COMPLETION / OPERATION PERMIT / EXISTING SYSTEM INSPECTION

PROPERTY DESCRIPTION NO. 15208 DATE 9/21/93 TAX MAP NO. 15P-A-41

OWNER OR CONTRACTOR WALTER O'NEAL PHONE: Business Home

ADDRESS

LOCATION NC 115 N, TR ZEB ROAD, ~ 1/2 MILE PAST PAVEMENT END, DRIVE ON (L) BEFORE CREEK

SUBDIVISION BLOCK / SECTION LOT LOT AREA ~7 ACRES SITE CLASS LTAR 0.35 GPD/FT2

Water Supply: ☑ Individual ☐ Community ☐ Public WELL

Septic Tank: 1000 Gallons: STB 620 Date 7/17/93

Pump Tank: Gallons: PT Date

Nitrification Field: No Fields 1 Square Feet 1035 Linear Feet 345

No Lines 4 Trench Width 36" Trench Depth 36" Gravel Depth 12"

☑ New System ☐ Repair System Type: I II III IV V VI

System Description: CONV. GRAVITY

Repair System Description: CONV. GRAVITY

Maintenance Agreement Required: ☐ Yes ☑ No

☐ House/Mod. Home ☑ Mobile Home ☐ Business ☐ Other PLANNED FOR FUTURE 3BR

No Bedrooms 3 No Bathrooms 1½ No Employees

Garbage Disposal: ☐ Yes ☑ No

Auto Dishwasher ☑ Yes ☐ No


Auto Washing Machine ☑ Yes ☐ No

Other


☐ Slab ☐ Crawl Space ☐ Basement w/plumbing ☐ Basement w/o plumbing

Comments TEMPORARY CAMPER / MH TO BE REMOVED UPON OCCUPANCY OF FUTURE HOUSE.

INITIAL SITE SKETCH

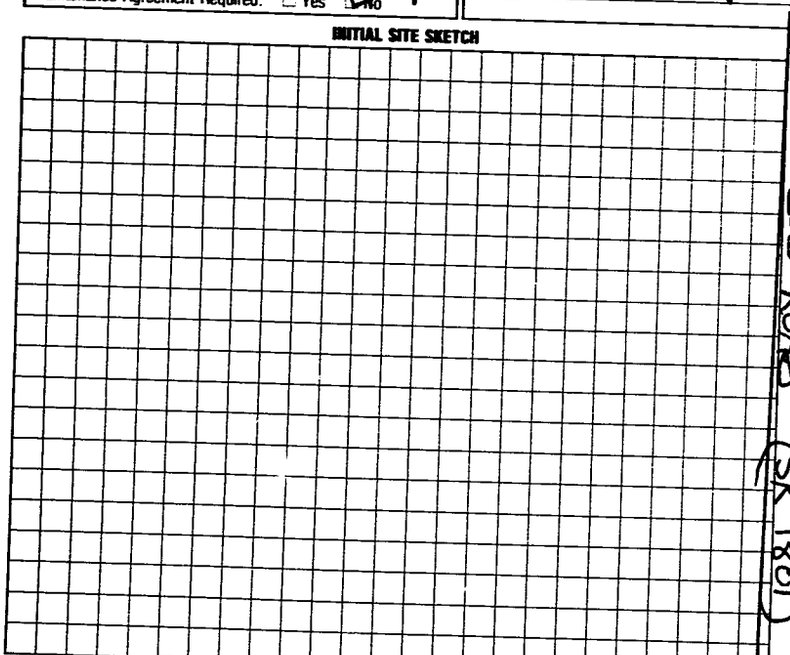

AS BUILT SKETCH

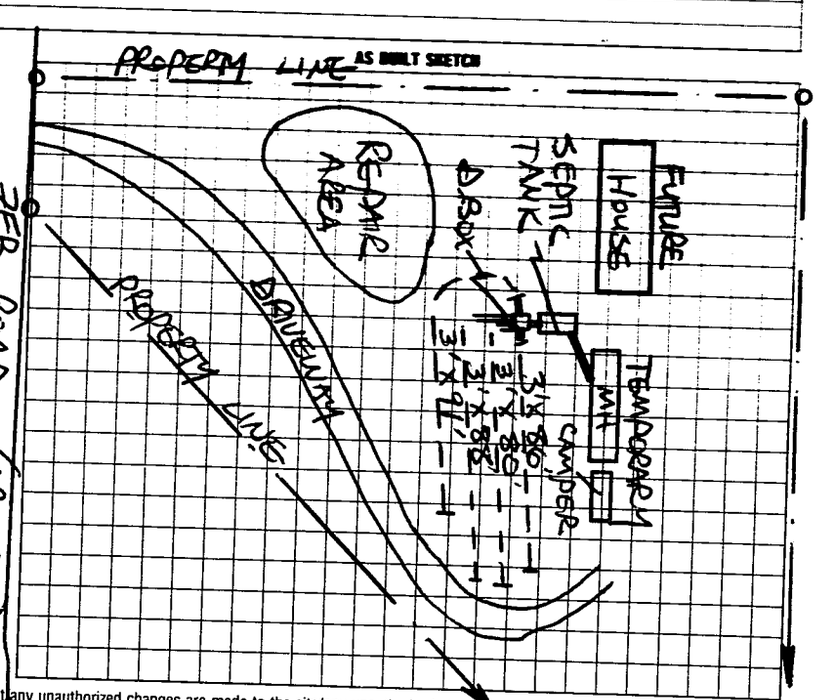

I understand that this permit can be suspended or revoked if any false information is supplied toward securing the permit, any unauthorized changes are made to the site/any unauthorized changes are made in the installation of the system. Improvement Permit is valid for 60 months from date of issuance.

Signed:

Improvement Permit by: STEVE HEDRICK date 9/21/93

Existing System Inspection by: date

Installed by: SAMMY REAVIS

Certificate of Completion by: STEVE HEDRICK date 9/21/93

Operation Permit by: date

HEALTH DEPT. COPY: WHITE INSPECTION COPY (FINAL): GREEN OWNER COPY (FINAL): YELLOW INSPECTION COPY (INITIAL): PINK OWNER COPY (INITIAL): GOLD