IREDELL COUNTY HEALTH DEPARTMENT

Statesville Office (704) 878-5305 Mooresville Office (704) 660-3625 PERMIT # 202230

IMPROVEMENT PERMIT / AUTHORIZATION TO CONSTRUCT / OPERATION PERMIT / EXISTING SYSTEM

PIN # 4830002496

APPLICANT: James Garrear APPLICANT ADDRESS: 115 Dobson Farm Rd.

SITE ADDRESS: 115 Dobson Farm Rd. PHONE: 815-93[illegible]-9868 ALT. PHONE: N/A

SITE DIRECTIONS: Hwy 115 N TR Harris Grove Rd. TL N. Chipley Ford Rd TL Dobson Farm Rd. 1st Drive on Left

SUBDIVISION: J E King Farm SECTION: M1 LOT # 30 LOT AREA: 18.49 acres DESIGN FLOW: 360gpd L.T.A.R.: 0.03

Septic Tank 1000 (gal) STB 10 12 Date 3-17-14
Pump Tank N/A (gal) PT N/A Date N/A
Pump Make N/A Model Tollette Serial # EF-4
Nitrification Fields 1 # Lines 3 Linear Ft: 300
Trench Width 36" Max. Trench Bottom Depth 36" Gravel Depth N/A


☐ New System ☑ Repair ☐ Expansion System Type: I II (III) IV V VI
System Description: R
Repair System Description: 25% Reduction
Maintenance Agreement Required: ☐ YES ☑ NO
☑ GRAVITY ☐ PRESSURE

☑ Residence No. Bedrooms 3
☐ Business No. Persons 6
☐ Other No. Employees
☐ Slab ☑ Crawl Space
☐ Basement w/plumbing ☐ Basement w/o plumbing


Water Supply: ☑ Private ☐ Public ☐ Community

Comments / Conditions: Install a 25% Reduction system on contour with serial distribution.

INITIAL SITE SKETCH

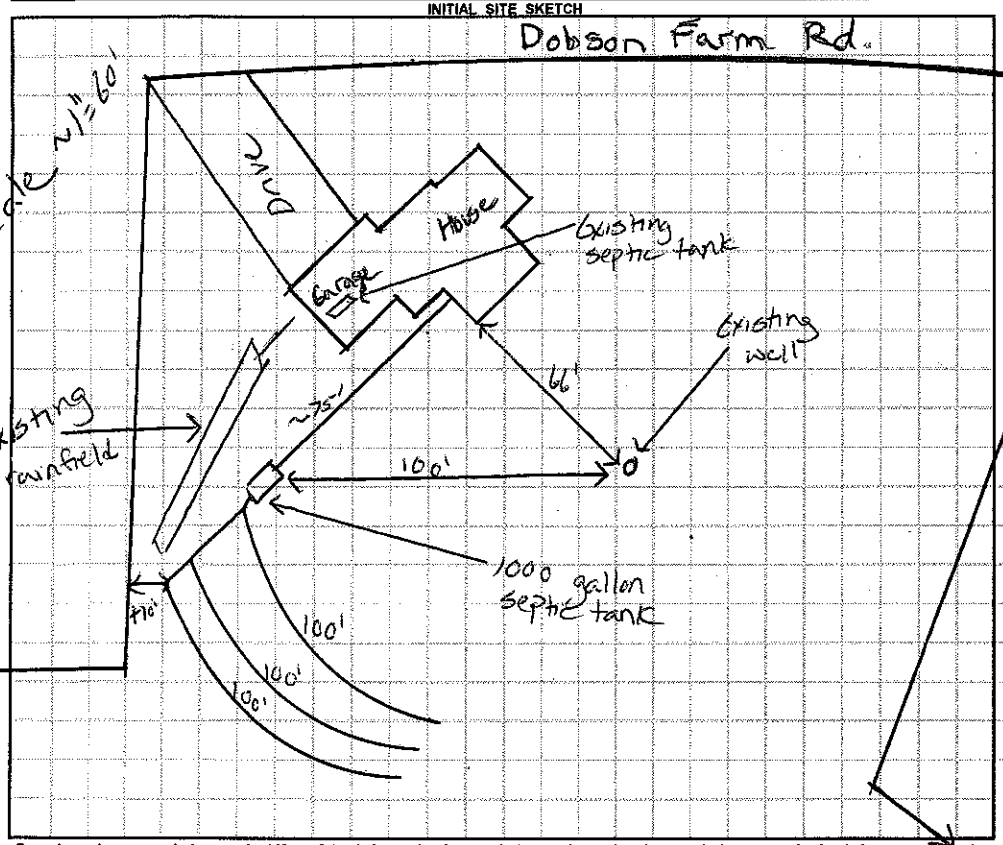

AS BUILT SKETCH

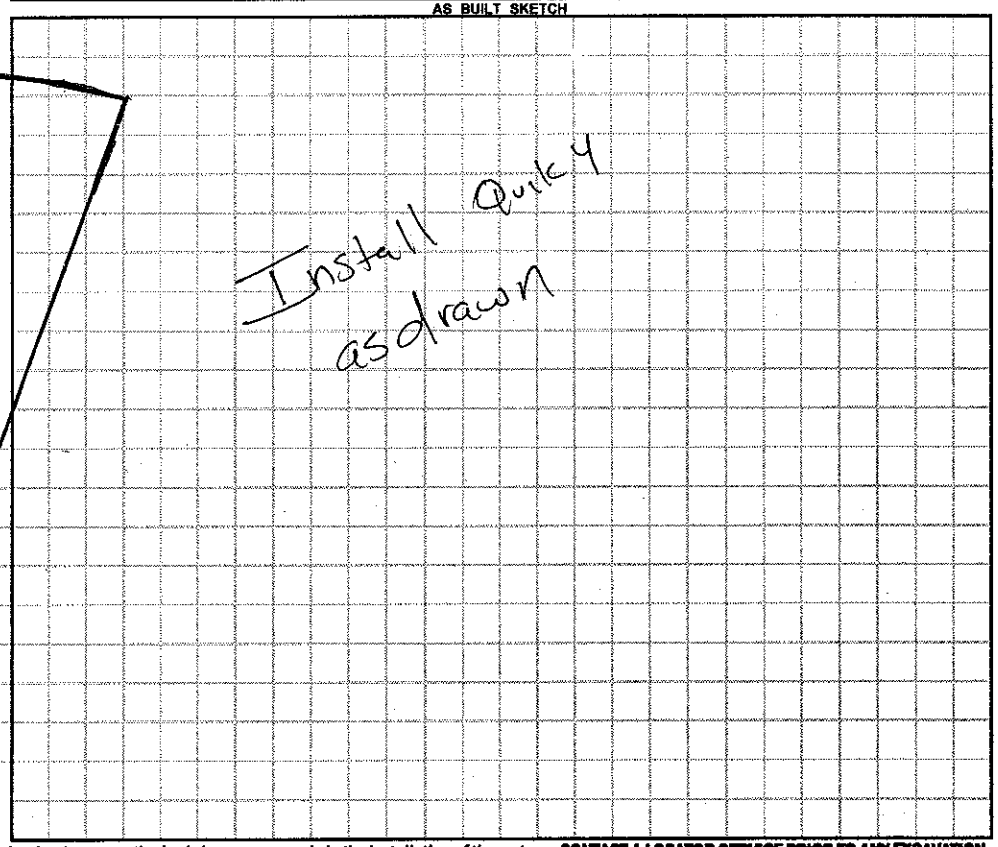

Permit can be suspended or revoked if any false information is supplied toward securing the permit / any unauthorized changes are made to the site / any unauthorized changes are made in the installation of the system. **CONTACT A LOCATOR SERVICE PRIOR TO ANY EXCAVATION**

☐ **IMPROVEMENT PERMIT** *with plat valid without expiration.* ☑ **IMPROVEMENT PERMIT** *with site plan valid for 60 mos.* ☑ **AUTHORIZATION TO CONSTRUCT** *valid for period equal to IMPROVEMENT PERMIT--not to exceed 60 mo.*

Owner / Applicant Signature: James Garrear Date: 4-17-14 Installed by: Steve Jordan

IMPROVEMENT PERMIT by: Justin Henderson Date: 4-2-14 OPERATION PERMIT by: Robert H Lowe Date: 06/03/14

AUTHORIZATION TO CONSTRUCT by: Justin Henderson Date: 4-2-14 Existing System Inspected by: Date:

Health Dept. Copy - WHITE Applicant (Final Approval) - YELLOW Applicant (Conditional Approval) - PINK